ADDENDUM NO. 1

DATE: July 10, 2024

PROJECT: East Providence Police Department Renovations

750 Waterman Avenue

East Providence, Rhode Island

FROM: JCJ Architecture

21 West 3rd Street Boston, Massachusetts

617-532-6600

TO: Bidders of Record

This Addendum forms a part of the Contract Documents and modifies the original Bidding Documents dated June 21, 2024. Acknowledge receipt of this Addendum in the space provided on the Bid Form. Failure to do so may subject the Bidder to disqualification.

This Addendum consists of (2) pages and the following attached documents:

- 1. Drawings.
- 2. Updated Bid Advertisement page
- 3. Pre-Bid Walkthrough Attendance Sheet

GENERAL:

- 1. The bid opening date has been extended from Wednesday, July 24, 2024 at 11:00am to Thursday, August 1, 2024 at 11:00am. The location of the bid opening remains the same.
- 2. The deadline to submit questions has been extended from Wednesday, July 17, 2024 to Wednesday, July 24, 2024 at 4:00pm.
- 3. The roof was replaced within the past year by Patrick J. McKenna Roofing, Inc.
- 4. Separate addenda will be issued to address questions and concerns that were posed during the prebid walkthough.

RE-ISSUED DRAWINGS:

1.	AD-112	Architectural Demo Plan – Main Level Overall
2.	A-112	Architectural Plan – Main Level Overall
3.	E-002	Lighting Fixture Schedule
4.	ED-111	Lower Level – Lighting Demo
5.	ED-112	Main Level – Lighting Demo
6.	ED-211	Lower Level – Electrical Demolition Plan
7.	E-111	Lower Level – Lighting Plan
8.	E-112	Main Level – Lighting Plan

071024.0348 Addendum No. 1
B23036.01 Page 1

EAST PROVIDENCE POLICE DEPT. RENOVATIONS 750 WATERMAN AVENUE EAST PROVIDENCE, RHODE ISLAND

9.	E-211	Lower Level – Power Plan
10.	E-212	Main Level – Lighting Plan
11.	E-511	Lower Level – Security Plan
12.	E-512	Main Level – Security Plan
13.	T-111	Lower Level – Technology Plan
14.	T-112	Main Level – Technology Plan
15.	T-200	Technology Riser

REQUEST FOR INFORMATION:

Bentley Companies, RFI Dated 7/10/2024

- 1. **Q**: Can you confirm that the bid will be extended to August 1st
 - A: Confirmed

Maron Construction Company, RFI Dated 7/01/2024

- 2. **Q**: It is 4th of July week with most contractors taking holiday for the rest of this week. With this "lost week" we ask you to consider adding a week to the bid date.
 - A: Bid opening has been extended to August 1, 2024 at 11am

Collins Construction Company, RFI Dated 7/01/2024

- 3. **Q**: Can you please provide the estimated cost of the referenced project to assist in bonding capacity?
 - A: Estimated cost of construction for base bid work is \$2.6 million. Estimated cost of construction with both alternates accepted is \$3.4 million.

H.V. Collins Company, RFI Dated 7/09/2024

- 4. **Q**: The Project Manual included Specification Section 105113 Metal Lockers; however, none are indicated on the drawings. Are there metal lockers? If yes, where are they located?
 - **A**: Metal lockers are located in detention area. Refer to 10/A-410 for location and 5/A-710 for detail.
- 5. **Q**: What is the approved Construction estimate for this project?
 - **A**: Refer to question #3 above.

END OF ADDENDUM NO. 1

071024.0348

Addendum No. 1

Page 2



CITY OF EAST PROVIDENCE EAST PROVIDENCE POLICE DEPARTMENT REQUEST FOR PROPOSALS RFP EP23/24-34 EAST PROVIDENCE POLICE DEPARTMENT RENOVATIONS BID OPENING THURSDAY, AUGUST 1 AT 11:00AM

The City of East Providence is seeking proposals from qualified firms for the full renovation of its Police Station.

The will be a pre-bid site visit/walkthrough at the East Providence Police Department, located at 750 Waterman Ave, East Providence, RI 02914 on Tuesday, July 9, 2024 at 1:00pm.

Specifications may be downloaded from the City's website https://eastprovidenceri.gov/rfp

One (1) original, two (2) copies and 1 Thumb Drive of the proposal shall be submitted in one (1) sealed envelope to East Providence City Hall, Controllers Office, Room 103, Attn: Jessica Lamprey, Procurement Specialist, 145 Taunton Ave., East Providence, RI 02914 no later than **THURSDAY**, **AUGUST 1, 2024 AT 11:00AM**. The bids will be opened and publicly recorded on the same day, in Conference Room A. Bids received with a time of 11:01 AM or later will be rejected. The outside envelope needs to be marked **RFP EP23/24-34 EAST PROVIDENCE POLICE DEPARTMENT RENOVATIONS**.

The City reserves the right to waive any informality in order to reject any or all bids if deemed to be in the best interest of the City.

Any questions must be submitted in writing Keith Mercy, Senior Project Architect, JCJ Architecture, at KMercy@jcj.com and Jessica Lamprey, Procurement Specialist at jlamprey@eastprovidenceri.gov no later than Wednesday, July 24, 2024 at 4:00pm.

Equal Opportunity/Affirmative Action Employer

Jessica Lamprey, Procurement Specialist <u>jlamprey@eastprovidenceri.gov</u>




CITY OF EAST PROVIDENCE POLICE DEPARTMENT RFP EP23/24-34 EAST PROVIDENCE POLICE DEPARTMENT RENOVATIONS PRE-BID WALKTHROUGH: JULY 9, 2024 1:00PM

	Connectivity	SYNET INC	Collins Construction	SMS	Johnson Systems Mank Wences 508720 7186	E, WiBurmano, Inc	Notin Electric inc	th Collan	H.W. COLLINS CO	Vendor Name
0	Macbillinzen	JAY PETERS	Ashley La Cunha 4019241438	Madeline Papez 978 305-3059	Morl Waris	Bob Dandeneau	MAT JOE	JUNT Caubinea	HARMED STEWART	Contact Name
	401-241-109	401-862-1326	4019241438	978 305-3659	508 720 7186	401-736-5400 ent 401-355-247a	8445-449 (OH	40 42 408	401.989.2249	Contact #
	snacgillivan	Shevent Sooned Com	ashley@collinsconst.net	Q Mericobal Services	Mulencis e Donneyon, com	estimative @	Notice the com	M Confinence Con	instemente involvius, com	Email Address
	Meny	and B	+026	Muela H	com fallen	James	Doc !		om the	Signature



CITY OF EAST PROVIDENCE POLICE DEPARTMENT RFP EP23/24-34 EAST PROVIDENCE POLICE DEPARTMENT RENOVATIONS PRE-BID WALKTHROUGH: JULY 9, 2024 1:00PM

9			TOWER	Central Painting, LLC	Bertier Companies Jim Hirus.	Vendor Name
			DERRICK PAPA	mario Diez	J. m. Hicas.	Contact Name
			401.943.0110	401-359-1999	617 338 6361	Contact #
			estimating @ tower	mariod lo Central Painting	hills@bentley	Email Address
			O.P.			Signature

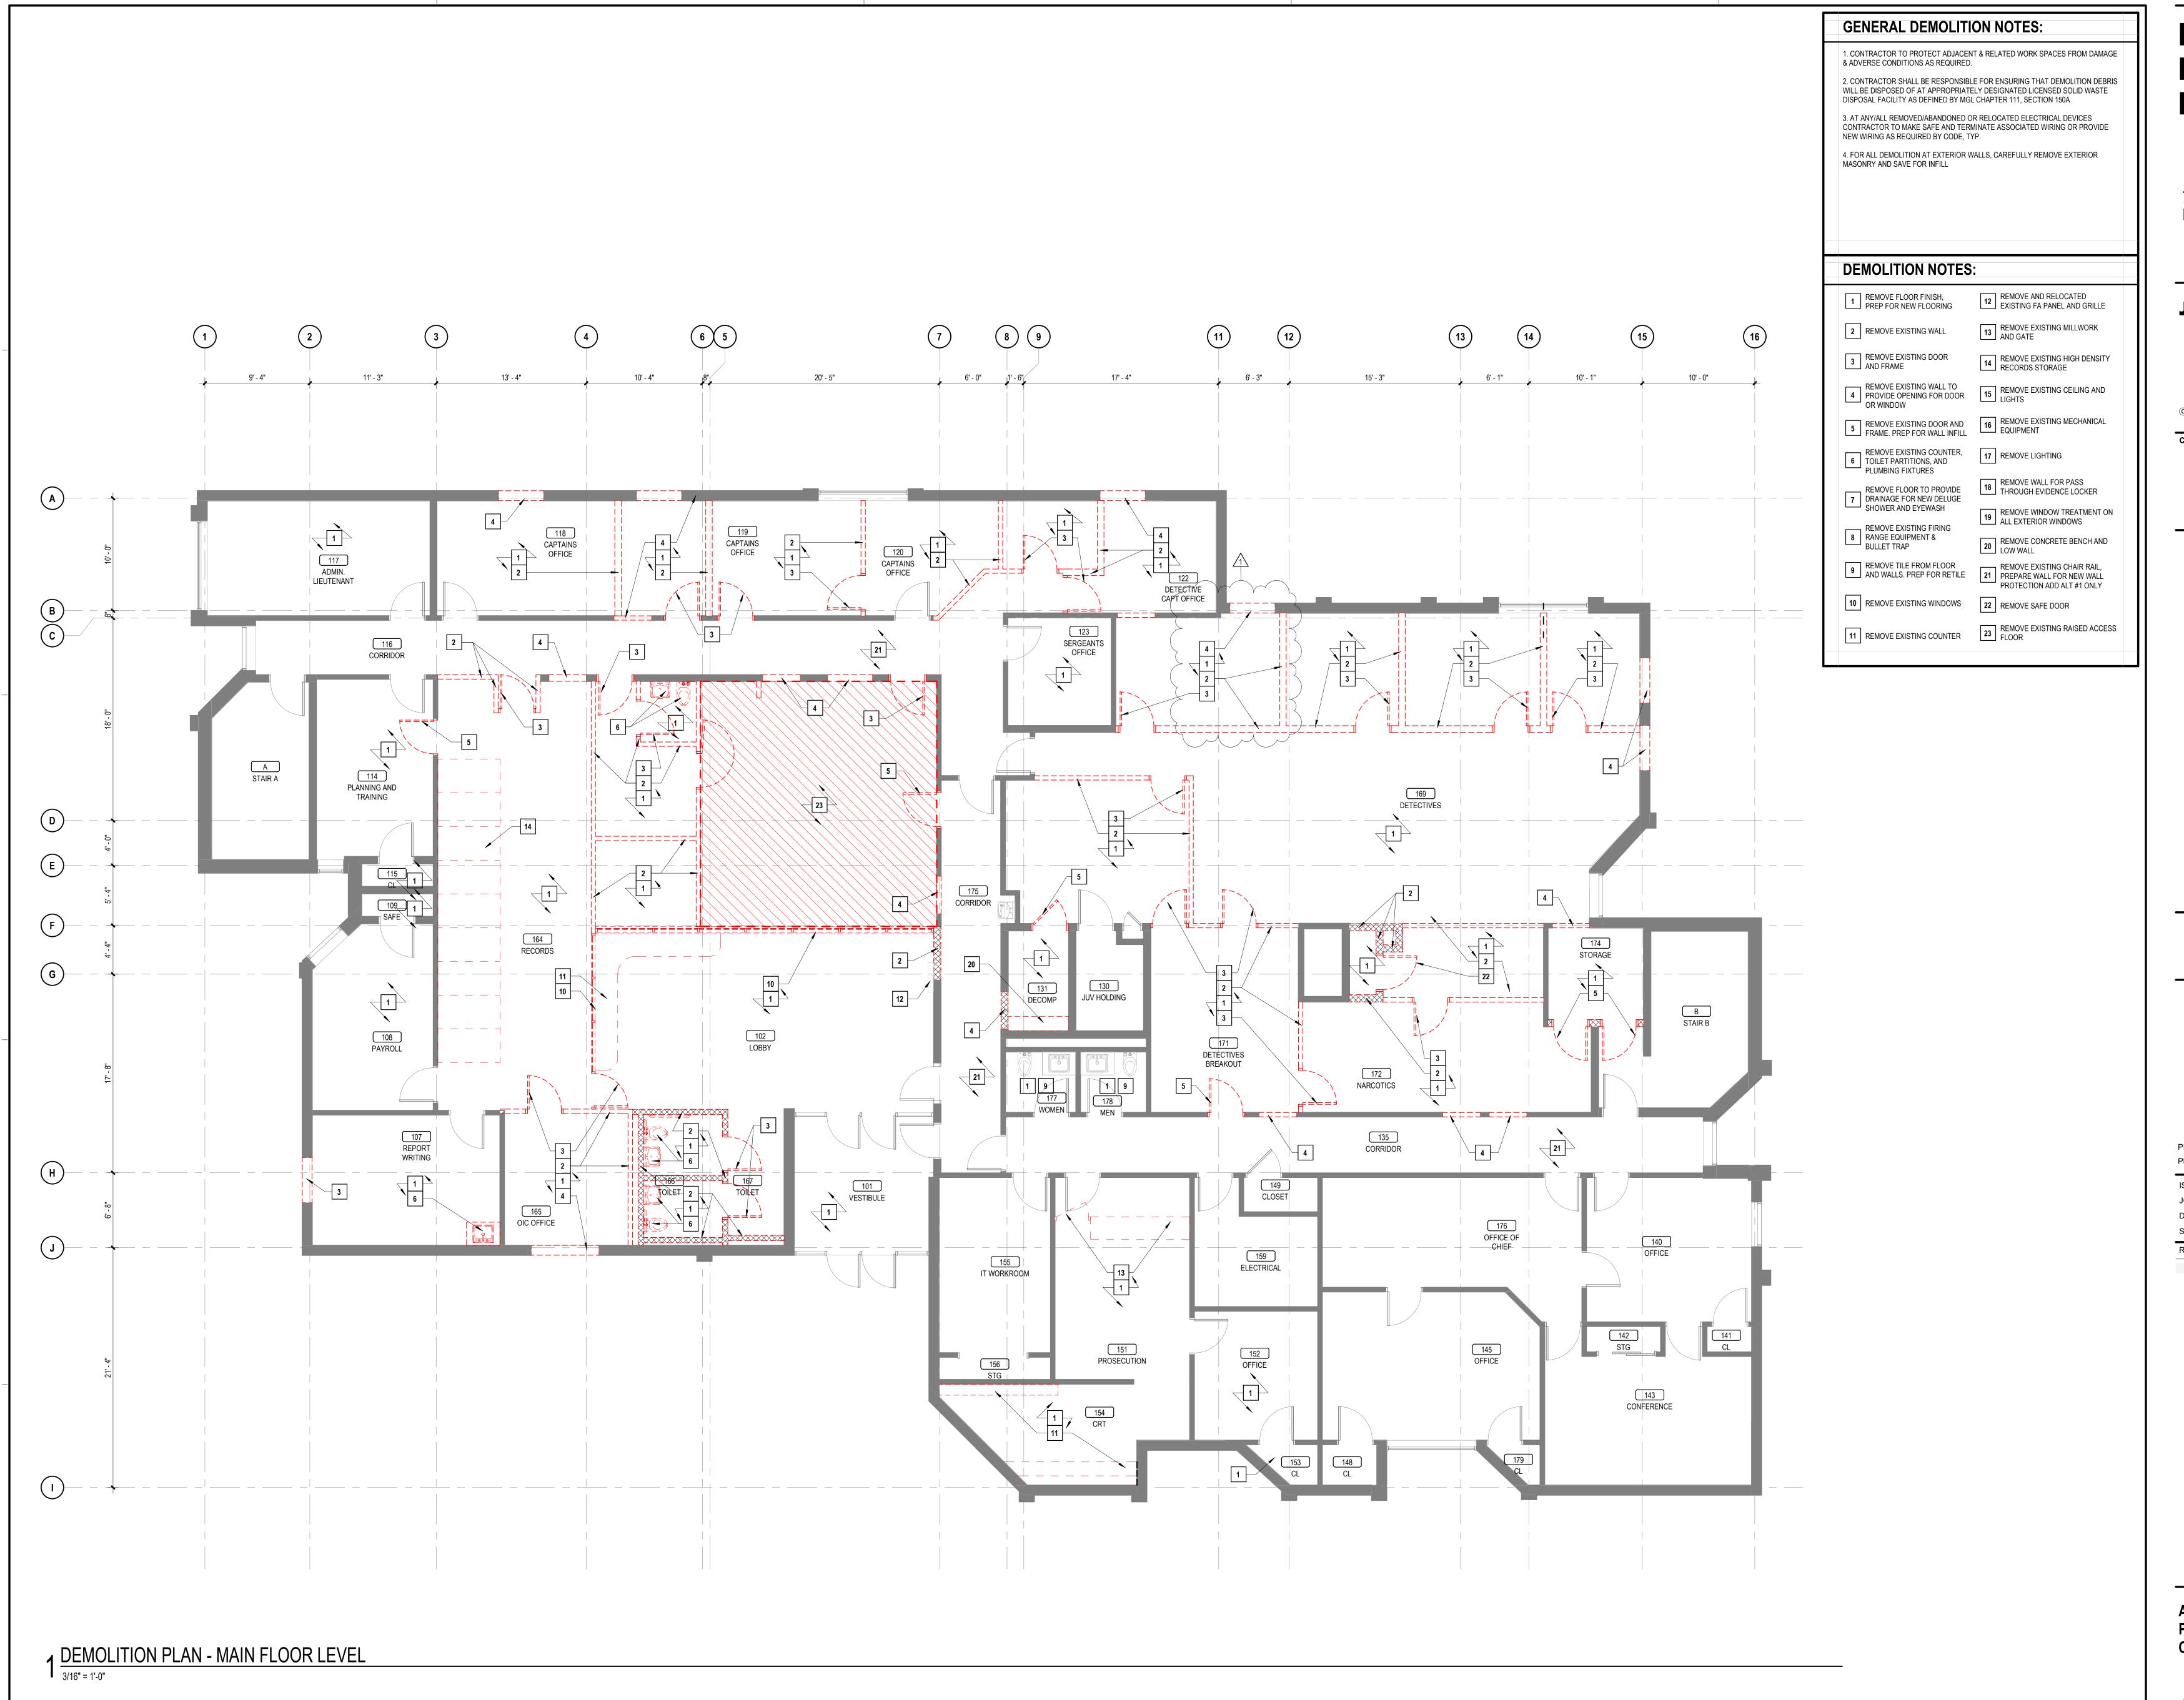

750 WATERMAN AVE East Providence, RI 02914

JCJARCHITECTURE

120 HUYSHOPE AVENUE
SUITE 400

HARTFORD, CT 06106

© 2023 JCJ Architecture

860.247.9226

© 2020 000 7 Hornicolare

CONSULTANT:

Reference Cover Sheet for Consultant Directory

> ADDENDEM 1 07/10/2024

CONSTRUCTION CONSTRUCTION

[DKR] _____ DL [SB]

ISSUE ISSUE DATE

JOB B23036.01

DRAWN Author

SCALE As indicated

REVISIONS

07/10/2024 Addendum 1

ARCHITECTURAL DEMO PLAN – MAIN LEVEL OVERALL

AD-112

750 WATERMAN AVE EAST PROVIDENCE, RI 02914

JCJARCHITECTURE

120 HUYSHOPE AVENUE
SUITE 400
HARTFORD, CT 06106
860.247.9226

© 2023 JCJ Architecture

CONSULTANT:

Reference Cover Sheet for Consultant Directory

ADDENDEM 1 07/10/2024

COMPTRUCTION

IC [DKR] _____ DL [SB]
M [KM] ____ DTL [KM]

JOB B23036.01

DRAWN Author

DRAWN Author

SCALE As indicated

REVISIONS

07/10/2024 Addendum 1

ARCHITECTURAL PLAN -MAIN LEVEL OVERALL

A-112

TYPE MANUFAC	MANUFACTURER	MODEL / SERIES	MTG.	VOLTAGE	LIGHTING SOURCE			DESCRIPTION	ACCEPTABLE MANUFACTURER	SCHEDULE NOTE
	WATER	WOBEL / CENTES	LUMENS WATTS SOURCE/CCT	Beettii Heit	EQUALS					
J	STONCO	VWXL-14-NW-G1-8	S/W	UNIVERSAL	1,390	14	LED/4000K	UTILITY JELLY JAR STYLE FIXTURE WITH FROSTED HEAT TREATED GLASS GLOBE AND CAST GUARD CAPABLE OF 0-10V DIMMING	HUBBELL CANLET	-0000
LP8	AXIS LIGHTING	TB3ILED-1200-80-35-BW-8-W-UNV-DP-1-	S	UNIVERSAL	1,200/FT	8/FT	LED/3500K	LED ACRYLIC INDIRECT FIXTURE WITH AIR CRAFT CABLE	LITHONIA	-00000
1.544		CA(36) BBRLED-1000-80-35-FL-S(14)-W-UNV-	سيس					FOR SUSPENSION. 4"X 14-0" APERTURE LINEAR SLOT FIXTURE WITH STANDARD	BHE WILLIAMS HE WILLIAMS	
LR14	AXIS LIGHTING	DP-1-*	R	UNIVERSAL	1,000/FT	9.5/FT	LED/3500K	LAMBERTION DISTRIBUTION	LUMENWERX	13 (
LR22	COLUMBIA LIGHTING	LCAT22-35-ML-G-ED-U	R	UNIVERSAL	3,494	25.8	LED/3500K	2' X 2' LED RECESSED ARCHITECTURAL TROFFER FIXTURE WITH FROSTED LENSING AND 0-10V DIMMING CAPABILITY.	AXIS LUMENWERX	-00000
LR24	COLUMBIA LIGHTING	LCAT24-35-HL-G-ED-U	R	UNIVERSAL	5,723	39.7	LED/3500K	2' X 4' LED RECESSED ARCHITECTURAL TROFFER FIXTURE WITH FROSTED LENSING AND 0-10V DIMMING CAPABILITY.	AXIS	-0-0-0
		RMCD-2-FL/SA-1-N/A-67L35K-DCC-			,			2'X2' HOLDING AREA TROFFER W/ DOUBLE LENSING, WELDED HOUSING,	LUMENWERX CERTOLUX	
LRV22	KENALL	N/A-DV-SYM/7-1-LEL-SC	R	UNIVERSAL	6,430	74	LED/3500K	CONCEALED PIANO HINGE RATED FOR DETENTION APPLICATION	AEL	
LS4	ELITE LIGHTING	4-OC1-LED-5000L-DIM10-MVOLT-35K-85-	S/P	UNIVERSAL	4,542	37	LED/3500K	4' LED LINEAR UTILITY FIXTURE WITH FROSTED ACRYLIC LENS AND	CORONET	-0-0-0
	ELITE EIGITTING	OCVH	071	ONIVEROAL	7,072	07	LLD/00001C	DIMMING CAPABILITY AND PROVIDED WITH CHAIN MOUNTING KIT.	MERCURY	
LS8	ELITE LIGHTING	8-OC1-LED-10000L-DIM10-MVOLT-35K- +85-©€V⊭↑	S/P	UNIVERSAL	9,503	76	LED/3500K	8' LED LINEAR UTILITY FIXTURE WITH FROSTED ACRYLIC LENS AND DIMMING CARABILITY AND PROVIDED WITH CHAIN MOUNTING KIT.	CORONET	
LSS	AXIS LIGHTING	SCWDPAT-S(6')-OPR(90+90+90+90)- 300-80-35-FL-EX-W-UNV-DP-1	S	UNIVERSAL	300/FT	3.25/FT	LED/3500K	WALL MOUNTED, DIRECT PATTERN FIXTURE, WITH FLUSH LENS. COORDINATE EXACT LENGTHS PRIOR TO ORDERING.	CORONET MERCURY	13
LT8	ELITE LIGHTING	BBRLED-1000-80-35-FL-6-W-UNV- DP-1-*	R	UNIVERSAL	1,000/FT	9.5/FT	LED/3500K	4" X 6'-0" APERTURE LINEAR SLOT FIXTURE WITH STANDARD LAMBERTION DISTRIBUTION	HE WILLIAMS LUMENWERX	12 0
RC1	ELITE LIGHTING	HH4-LED-1200L-DIM10-MVOLT-MD-35K- 90+/HH4-4501-CL-WH-WH	F	UNIVERSAL	1,200	14	LED/3500K	4" APERTURE LED DOWNLIGHT FIXTURE WITH SEMI-SPECULAR REFLECTOR AND PROVIDED WITH 0-10V DIMMING CAPABILITY.	INTENSE ELITE	12 (
RC2	ELITE LIGHTING	HH4-LED-1200L-DIM10-MVOLT-SPD-35K-	F	UNIVERSAL	2,144	24	LED/3500K	4" APERTURE LED DOWNLIGHT FIXTURE WITH SEMI-SPECULAR	INTENSE	
1102	LLITE LIGITING	90+/HH4-4501-CL-WH-WH	'	UNIVERSAL	2,144	24	LLD/3300K	REFLECTOR AND PROVIDED WITH 0-10V DIMMING CAPABILITY.	ELITE	12
RC3	ELITE LIGHTING	HH4-LED-3000L-DIM10-MVOLT-MD-35K- 90+/HH4-4501-CL-WH-WH	F	UNIVERSAL	3,579	32	LED/3500K	4" APERTURE LED DOWNLIGHT FIXTURE. FINISH BY ARCHITECT. PROVIDED WITH 0-10V DIMMING CAPABILITY.	INTENSE ELITE	12
SL4	LIGHTOLIER (SIGNIEY)	GWM-A06-840-T4M-UNV-PCB-EC	w	UNIVERSAL	2,571	16	LED/3500K	LED WALL PACK WITH TYPE IV DISTRIBUTION, FINISH BY	KIM	(-)(-)(-)(-)(-)(-)(-)(-)(-)(-)(-)(-)(-)(
	ZIGITI GZIZIK (GIGINI 1)	CVVIII / 100 0 10 1 1III CIVV 1 0D E0		OTTIVE TO TE	2,071	10		ARCHITECT, PHOTO BUTTON CONTROL	HYDREL	
IU	EVENLITE	SOV-LED-XX-SERIES	S	UNIVERSAL	-	-	LED/3500K	WALL MOUNTED SIGN FIXTURE TO BE PROVIDED WITH "IN USE" WORDING IN BLUE ILLUMINATED LETTERS	EELP SIGNTEX	
X	CICNITEV	FLV AC 4 C * C PC		LINII\/EDCAL		0	ODEEN / LED	SINGLE FACED LED EDGE LIT EXIT SIGN WITH GREEN LETTERING	EVENLITE	+
X	SIGNTEX	ELX-AC-1-G-*-C-DG	U	UNIVERSAL	-	3	GREEN / LED	COORDINATE CHEVRONS WITH ARCHITECTURAL CODE PLAN	EELP	26
	SIGNTEX	ELX-AC-2-G-*-M-DG	U	UNIVERSAL	-	3	GREEN / LED	DOUBLE FACED LED EDGE LIT EXIT SIGN WITH GREEN LETTERING COORDINATE CHEVRONS WITH ARCHITECTURAL CODE PLAN	EVENLITE EELP	26
								SINGLE FACED LED EXIT SIGN WITH MASS. APPROVED WHEEL	EVENLITE	
Жнс	SIGNTEX	CAE-NB-1-G-C-*-NA-U-DG-MA	U	UNIVERSAL	-	2	GREEN / LED	CHAIR GRAPHIC LOCATED AT ANY EXIT FROM BUILDING TO GRADE.	EELP	-23
₫ ₽ EB	SIGNTEX	MLW-BB-10-*-DG	U	UNIVERSAL	710	10	LED/5000K	LED EMERGENCY BATTERY UNIT FIXTURE TYPICALLY MOUNTED AT	EVENLITE	2
								7' 6" A.F.F. AND PROVIDED WITH SELF DIAGNOSTIC CAPABILITIES	MULE	

PROVIDE ADDITIONAL SENSOR IN SCHEME

WHERE INDICATED ON PLAN..

MOUNTING DESIGNATIONS												
F	RECESSED IN FLANGE	U	UNIVERSAL									
Р	PENDANT	W	WALL									
G	RECESSED IN GRID	AC	AIRCRAFT CABLE									
S	SURFACE	BOL	BOLLARD									
Т	TRACK/RAIL/CABLE	POLE	POLE									
GR	IN GROUND											

LIGHTING CONTROL DEVICES NOTES


- ELECTRICAL CONTRACTOR SHALL PROVIDE SENSORS AS INDICATED ON PLANS; SENSOR PLACEMENT, SENSING TYPE, AND COVERAGE SHALL BE FULLY COORDINATED WITH THE ARCHITECTURAL REFLECTED CEILING PLANS TO ENSURE
- PROPER DETECTION IN EACH SPACE.

 2. ELECTRICAL CONTRACTOR SHALL PROVIDE LOAD CONTROLLERS FOR EACH FIXTURE OR ZONE INDICATED ON PLANS; LOAD CONTROLLER SWITCHING AND
- DIMMING FUNCTIONS SHALL BE AS REQUIRED FOR EACH LOAD TYPE. COORDINATE WITH APPROVED LIGHTING FIXTURE PACKAGE.


 3. ADDITIONAL SENSORS, LOW VOLTAGE STATIONS, LOAD CONTROLLERS, AND
- OTHER AUXILIARY DEVICES SHWON ON PLAN OR REQUIRED FOR ZONES
 CONTROLLED AND SEQUENCE OF OPERATION REQUIRED.
- CONTROLLED AND SEQUENCE OF OPERATION REQUIRED.

 4. ELECTRICAL CONTRACTOR SHALL PROVIDE ALL REQUIRED POWER AND CONTROL CABLING, RACEWAYS, SUPPORTS, BOXES, MISC. FITTINGS, AND LABOR REQUIRED FOR A COMPLETE FUNCTIONAL SYSTEM; REFER TO NOTES AND SPECIFICATIONS FOR ADDITIONAL REQUIREMENTS.

TWO ZONE W/ OCCUPANCY/VACANCY & MANUAL OVERRIDE

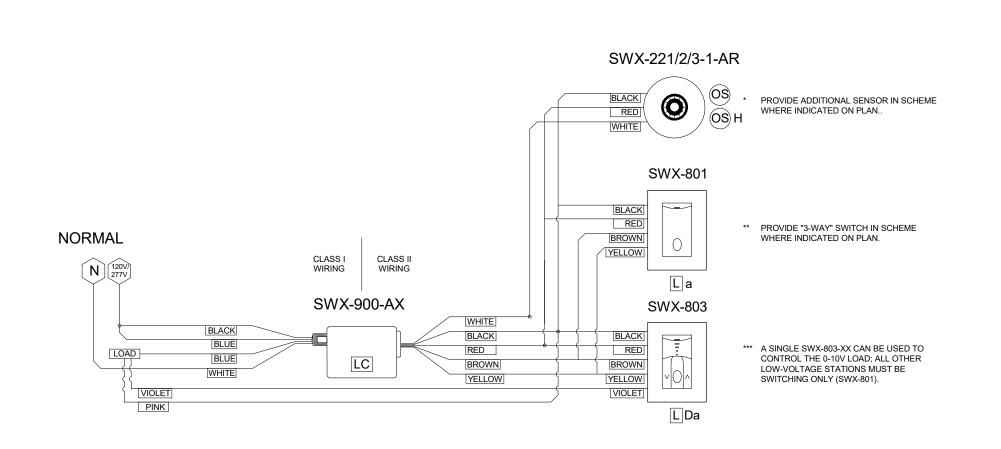

SINGLE ZONE W/ OCCUPANCY/VACANCY & MANUAL OVERRIDE

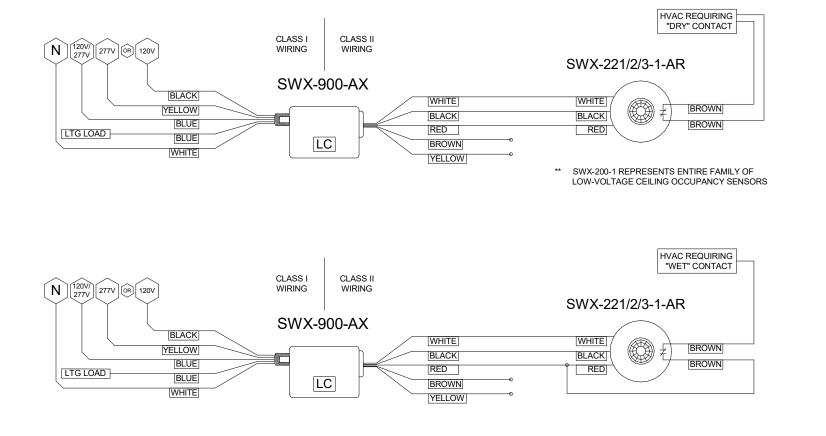

- ** AN HVAC SYSTEM THE REQUIRES THE SIGNAL VOLTAGE TO BE SOURCED EXTERNALLY IS SAID TO REQUIRE A WET CONTACT, WHILE AN HVAC SYSTEM THAT PROVIDES THE SIGNAL VOLTAGE REQUIRES A DRY CONTACT. THE MAJORITY OF HVAC SYSTEMS REQUIRE A DRY CONTACT.
 ** SWX-200-1-AR CAN BE PROGRAMMED TO OPERATE WITH NORMAL OR REVERSE LOGIC BASED ON OCCUPANCY.
 - HVAC OCCUPANCY/VACANCY SIGNAL OUTPUT OPTIONS

1 TYPICAL LIGHTING CONTROL DETAILS

E002 | SCALE: N.

LIGHTING FIXTURE SCHEDULE NOTES (-)

- 1. LIGHTING FIXTURE PACKAGE SUBMITTALS SHALL BE FULLY COORDINATED BETWEEN THE ELECTRICAL CONTRACTOR, LIGHTING FIXTURE REPRESENTATIVE(S), AND LIGHTING MANUFACTURERS TO ENSURE ALL PRODUCT, INSTALLATION, AND CONTROL REQUIREMENTS ARE MET PRIOR TO SUBMISSION FOR REVIEW. IT IS THE ELECTRICAL CONTRACTORS RESPONSIBILITY TO PROVIDE A PACKAGE MEETING ALL REQUIREMENTS OF THE PROJECT FOR
- A COMPLETE AND FULLY FUNCTIONAL LIGHTING SYSTEM.=
 2. PROVIDE EXIT SIGN THAT COMPLIES WITH NFPA 101, UL 924, 521 CMR 26.1.2 AND ALL
- REFERENCED STANDARDS AND CODES.
 3. PROVIDE FLOOR PROXIMITY SIGN IN ADDITION TO STANDARD SIGN ABOVE DOOR; MOUNT SIGN
- AT 18" A.F.F. TO THE TOP ON THE STRIKE SIDE OF DOOR. SIGN SHALL BE RECESSED MOUNTED AND PROVIDED WITH FLUSH POLYCARBONATE SHIELD.
- AND PROVIDED WITH FLUSH POLYCARBONATE SHIELD.

 4. SITE LIGHTING POLES SHALL BE PROVIDED WITH FULL BASE COVERS TO MATCH PROFILE OF
- SITE LIGHTING POLES SHALL BE PROVIDED WITH FULL BASE COVERS TO MATCH PROFILE POLE; NUT COVERS ONLY ARE NOT ACCEPTABLE.
- UNLESS OTHER NOTED, PROVIDE ALL FIXTURES WITH 0-10V DIMMING BALLAST, DRIVER, TRANSFORMER, OR LIGHT ENGINE REQUIRED FOR LAMP OR LED SOURCE SPECIFIED.
 E.C. SHALL PROVIDE ADDITIONAL EXIT SIGNS (TO INCLUDE 100' OF MC CABLE BRANCH

CIRCUITING) FOR FIELD PLACEMENT DURING CONSTRUCTION. REFER TO SPECIFICATIONS FOR

- QUANTITIES.

 7. PROVIDE ALCS ADDRESSABLE INPUT/OUTPUT (I/O) MODULE FOR EACH FIXTURE UNLESS OTHERWISE NOTED. APPLICATIONS NOT REQUIRING INDIVIDUAL CONTROL (WHERE NOTED ON PLANS) SHALL BE PROVIDED WITH I/O MODULES ON A FIXTURE GROUPING BASIS. WHERE FIXTURES ARE LOCATED IN HARD CEILING AREAS THE I/O MODULE SHALL BE REMOTE MOUNTED IN ACCESSIBLE AREA ABOVE AN A.C.T. CEILING. WHERE FIXTURES ARE LOCATED OUTDOORS THE I/O MODULE SHALL BE LOCATED IN THE MAIN ELECTRICAL ROOM ADJACENT TO THE PANEL
- ONE-LINE DIAGRAM" AND SPECIFICATIONS FOR FURTHER INFORMATION.

 8. PROVIDE LED SOURCES WITH MAXIMUM A MAXIMUM COLOR VARIATION OF 3-STEP MCADAM

SERVING THE LIGHTING. REFER TO "AUTOMATED LIGHTING CONTROL SYSTEM - TYPICAL

- ELLIPSE. PROVIDE STATEMENT OF COMPLIANCE WITH SUBMITTALS.

 9. PROVIDE FIXTURES WITH A MINIMUM WARRANTY COVERAGE OF 5 YEARS ON ALL PARTS.
 MANUFACTURER SHALL PROVIDE WRITTEN WARRANTY TO PROVIDE REPLACEMENT PARTS,
 INCLUDING BUT NOT LIMITED TO, LED SOURCE MODULE AND DRIVER FOR A MINIMUM OF TEN
 YEARS. PARTS SHALL BE FULLY COMPATIBLE WITH FIXTURE TO PROVIDE SAME LIGHT OUTPUT,
- DISTRIBUTION, COLOR, AND COLOR RENDERING AT OR BELOW THE ORIGINAL WATTAGE. PROVIDE STATEMENT OF COMPLIANCE WITH SUBMITTALS.

 10. PROVIDE FIXTURES WITH PROJECT SPECIFIC LABELS CLEARLY INDICATING THE FIXTURE TYPE, SERVICE CONTACT INFORMATION, AND REPLACEMENT PARTS (INCLUDING BUT NOT LIMITED TO SOURCE, DRIVER, AND LENS). MANUFACTURER STANDARD OFFERING OF QR CODE OR BAR
- CODE CONTAINING REQUIRED INFORMATION WILL BE ACCEPTABLE. PROVIDE STATEMENT OF COMPLIANCE WITH SUBMITTALS.

 11. PROVIDE FIXTURES FROM MANUFACTURERS WITH A DOCUMENTED HISTORY OF SUPPLYING
- PRODUCTS SPECIFIED FOR A MINIMUM OF 5 YEARS. PROVIDE STATEMENT OF COMPLIANCE WITH SUBMITTALS.

 12. FIXTURE FLANGE TYPES TO BE COORDINATED WITH ARCHITECT ON A PER LOCATION BASES
- 12. FIXTURE FLANGE TYPES TO BE COORDINATED WITH ARCHITECT ON A PER LOCATION BASES PROVIDE MARK-UP OF PROPOSED FLANGE TYPES FOR REVIEW PRIOR TO FINAL FIXTURE
- APPROVAL.

 13. FIXTURE LENGTHS TO BE COORDINATED WITH ELECTRICAL LIGHTING PLANS. PROVIDE ALL NECESSARY MOUNTING HARDWARE, DRIVERS, CONNECTOR CABLES, ETC. FOR RUNS SHOWN
- 14. FIXTURE MUST BE PROVIDED WITH ADJUSTABLE LENGTH STABILIZER / SAFETY CABLE
 15. FIXTURE SELECTED IS DLC LISTED THIS IS A REQUIREMENT FOR APPROVAL FOR THIS TYPE.
- 16. FIXTURE SELECTED IS DECEISTED THIS IS A REQUIREMENT FOR AFFROVAL FOR THIS TIPE.

 16. FIXTURE SHALL BE PROVIDED WITH AN UP-LIGHT SOURCE AND SAFETY HOOK MOUNTING CHAIN.
- 17. PROVIDE 7 PIN PHOTOCELL PROVISIONS FOR EACH POLE FIXTURE TO HOUSE THE WIRELESS
 SITE LIGHTING CONTROL MODULE (WSLC) SEE ALCS RISER. PROVIDE ONE WSLC PER FIXTURE.
 18. FIXTURES TO BE PROVIDED WITH DMX DIMMABLE DRIVER CAPABLE OF A SMOOTH DIM TO BLACK
- (0% TOTAL LIGHT OUTPUT).

EAST PROVIDENCE POLICE DEPT RENOVATIONS

750 WATERMAN AVE EAST PROVIDENCE, RI 02914

STATE PROJECT NUMBER < remove if not required>


JCJARCHITECTURE

120 HUYSHOPE AVENUE
SUITE 400

HARTFORD, CT 06106


860.247.9226

© 2023 JCJ Architecture

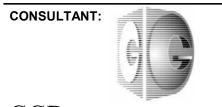

GGD CONSULTING ENGINEERS, INC. 375 Faunce Corner Road, Suite D, Dartmouth, MA 02747-1258 p: 508-998-5700 • f: 508-998-0883 • E-MAIL: info@g-g-d.com

CONSTRUCTION DOCUMENTS 06/03/2024

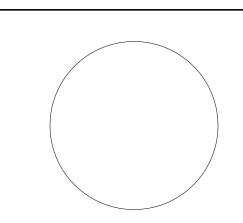

PIC [WHO] _____ DL [WHO] ____ PM [WHO] ____ DTL [WHO] ___

ISSUE ISSUE DATE


JOB JCJ PROJECT NUMBER: B23036.00

DRAWN_JR SCALE ____

REVISIONS

07/08/2024 Addendum 1

LIGHTING FIXTURE SCHEDULE

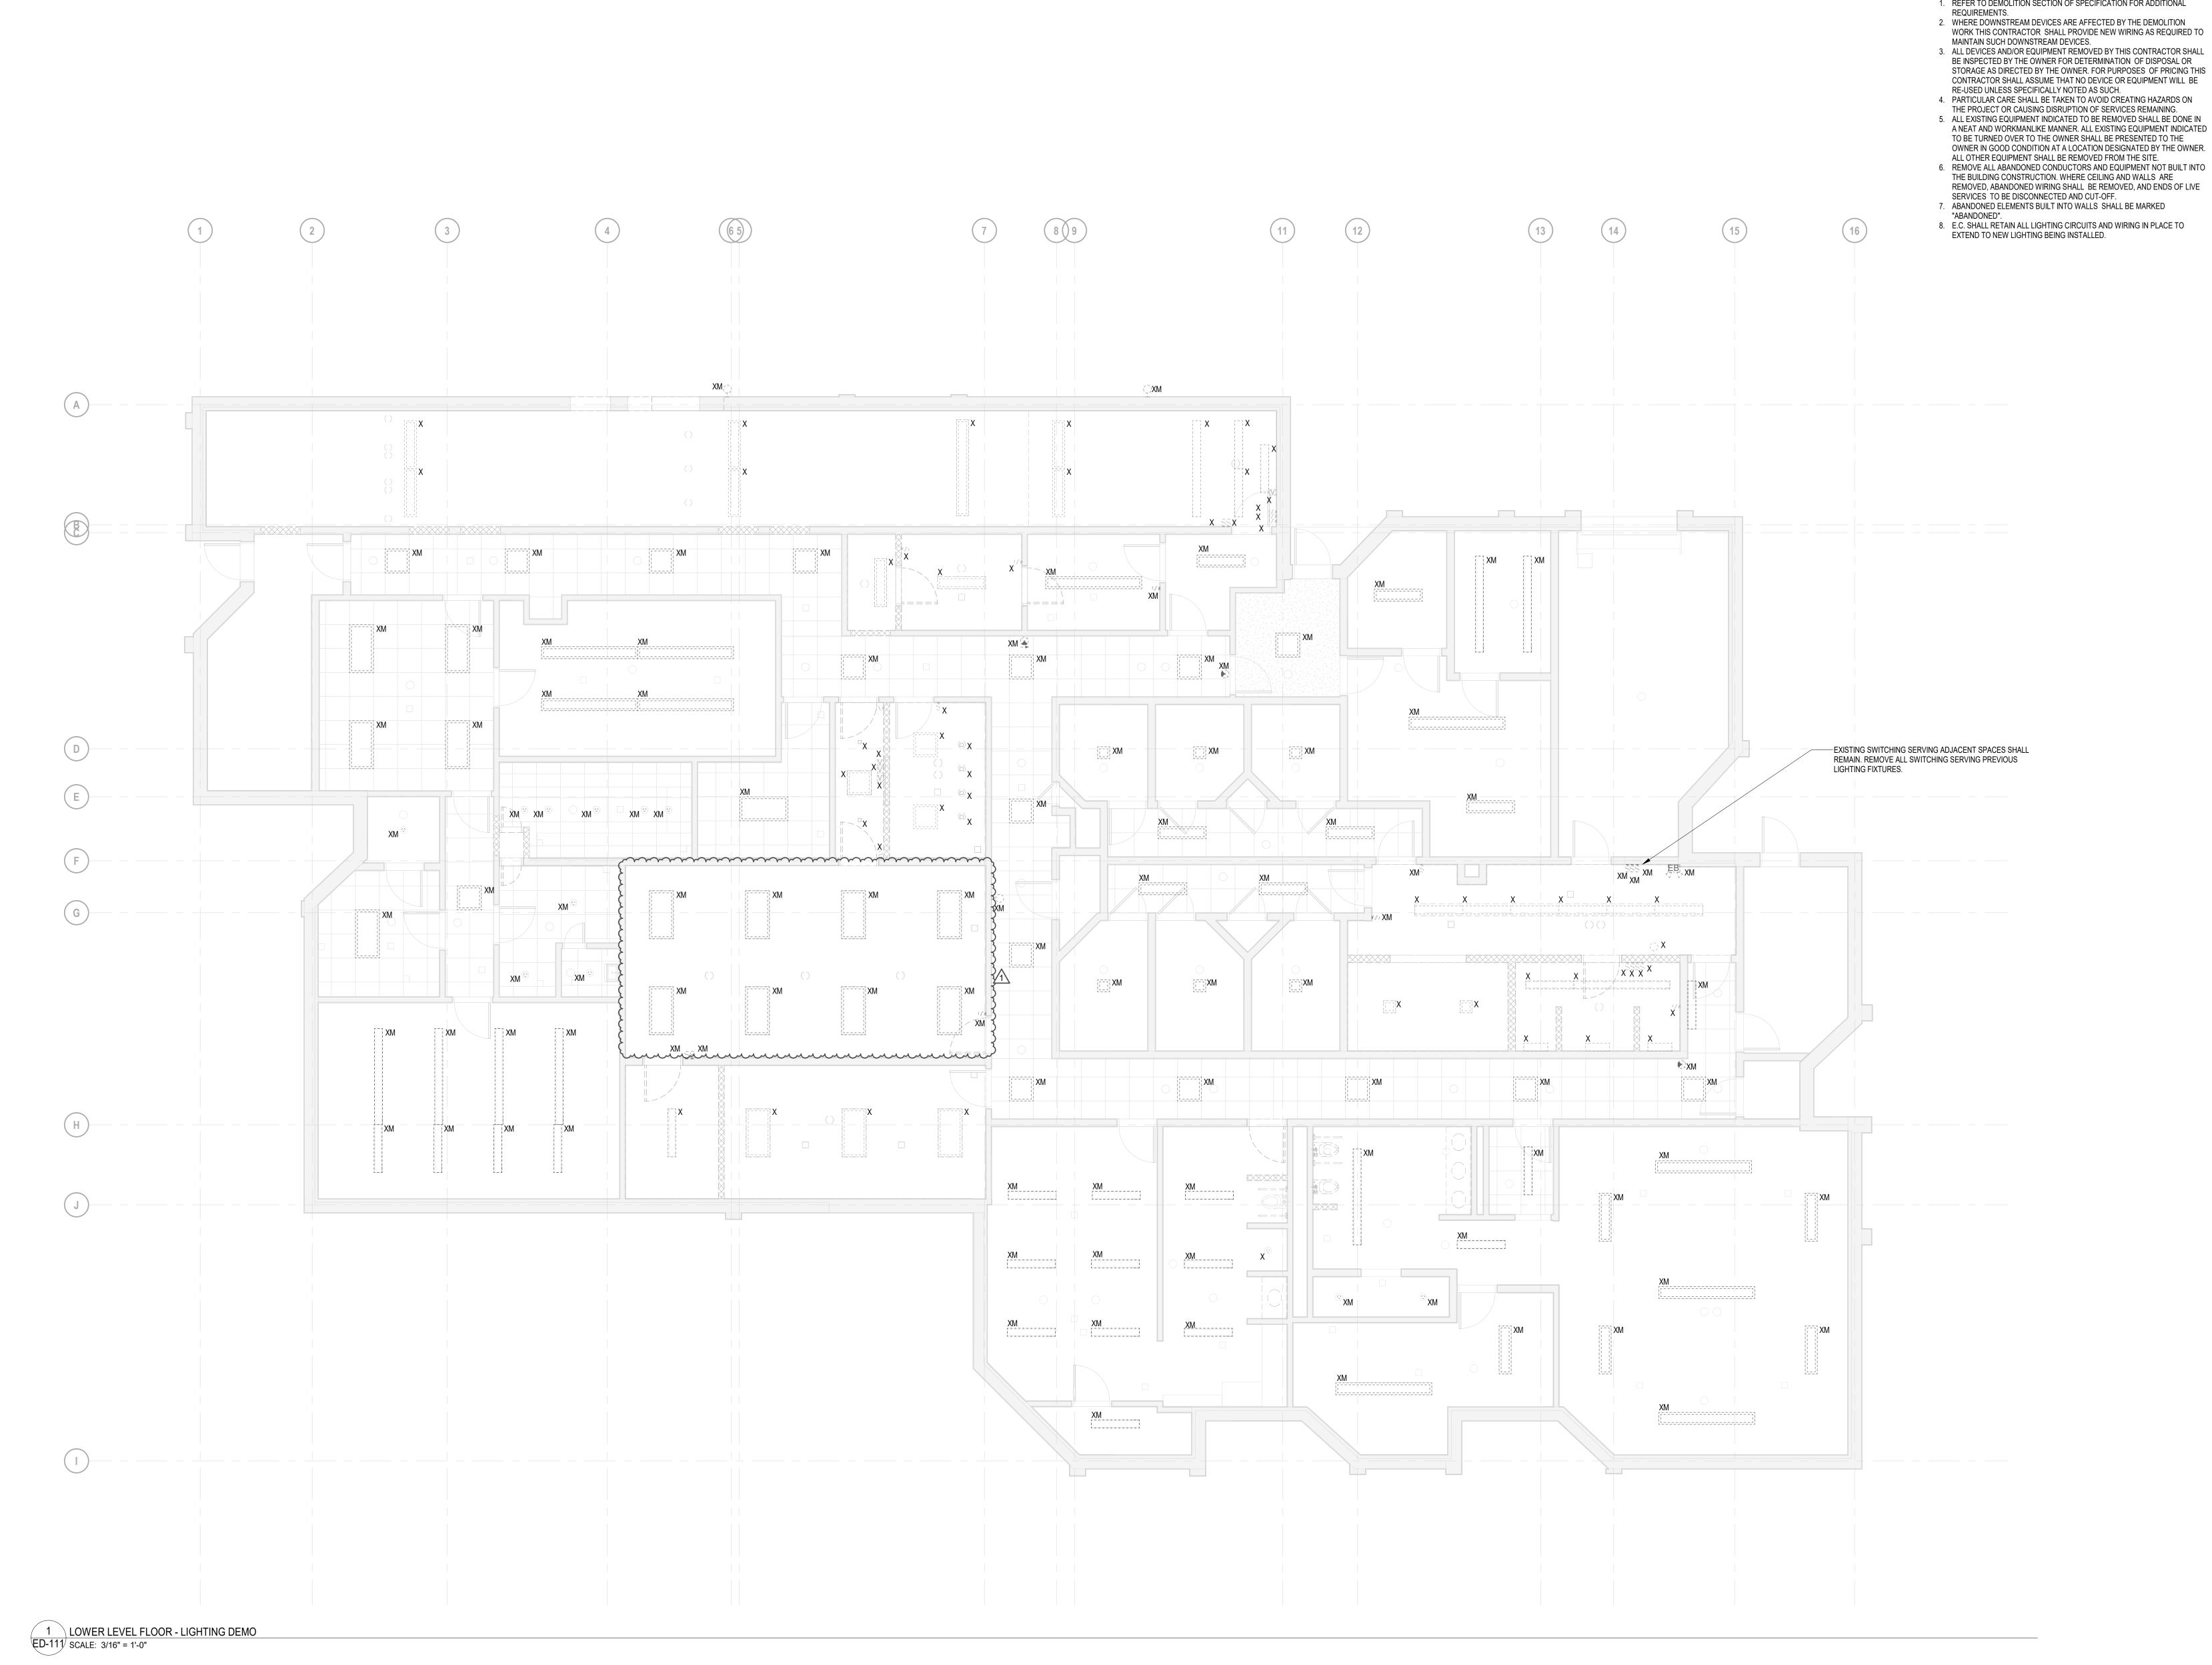

GENERAL DEMOLITION NOTES:

- 1. REFER TO DEMOLITION SECTION OF SPECIFICATION FOR ADDITIONAL 2. WHERE DOWNSTREAM DEVICES ARE AFFECTED BY THE DEMOLITION WORK THIS CONTRACTOR SHALL PROVIDE NEW WIRING AS REQUIRED TO
- 3. ALL DEVICES AND/OR EQUIPMENT REMOVED BY THIS CONTRACTOR SHALL BE INSPECTED BY THE OWNER FOR DETERMINATION OF DISPOSAL OR STORAGE AS DIRECTED BY THE OWNER. FOR PURPOSES OF PRICING THIS CONTRACTOR SHALL ASSUME THAT NO DEVICE OR EQUIPMENT WILL BE
- RE-USED UNLESS SPECIFICALLY NOTED AS SUCH.
 4. PARTICULAR CARE SHALL BE TAKEN TO AVOID CREATING HAZARDS ON THE PROJECT OR CAUSING DISRUPTION OF SERVICES REMAINING. 5. ALL EXISTING EQUIPMENT INDICATED TO BE REMOVED SHALL BE DONE IN A NEAT AND WORKMANLIKE MANNER. ALL EXISTING EQUIPMENT INDICATED
- OWNER IN GOOD CONDITION AT A LOCATION DESIGNATED BY THE OWNER. ALL OTHER EQUIPMENT SHALL BE REMOVED FROM THE SITE. 6. REMOVE ALL ABANDONED CONDUCTORS AND EQUIPMENT NOT BUILT INTO THE BUILDING CONSTRUCTION. WHERE CEILING AND WALLS ARE

HARTFORD, CT 06106

EAST PROVIDENCE

POLICE DEPT

750 WATERMAN AVE

EAST PROVIDENCE, RI 02914

RENOVATIONS

JCJARCHITECTURE 120 HUYSHOPE AVENUE SUITE 400


© 2023 JCJ Architecture

860.247.9226



GGD consulting engineers, inc. 375 Faunce Corner Road, Suite D, Dartmouth, MA 02747-1258 p: 508-998-5700 • f: 508-998-0883 • E-MAIL: info@g-g-d.com

> CONSTRUCTION DOCUMENTS 06/03/2024

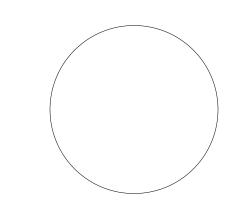

ISSUE _ISSUE DATE JOB __JCJ PROJECT NUMBER: B23036.00

DRAWN_JR SCALE As indicated

REVISIONS

07/08/2024 Addendum 1

LOWER LEVEL - LIGHTING DEMO

ED-111

GENERAL DEMOLITION NOTES:

- REFER TO DEMOLITION SECTION OF SPECIFICATION FOR ADDITIONAL REQUIREMENTS.
 WHERE DOWNSTREAM DEVICES ARE AFFECTED BY THE DEMOLITION WORK THIS CONTRACTOR SHALL PROVIDE NEW WIRING AS REQUIRED TO
- MAINTAIN SUCH DOWNSTREAM DEVICES.
 3. ALL DEVICES AND/OR EQUIPMENT REMOVED BY THIS CONTRACTOR SHALL BE INSPECTED BY THE OWNER FOR DETERMINATION OF DISPOSAL OR STORAGE AS DIRECTED BY THE OWNER. FOR PURPOSES OF PRICING THIS CONTRACTOR SHALL ASSUME THAT NO DEVICE OR EQUIPMENT WILL BE
- RE-USED UNLESS SPECIFICALLY NOTED AS SUCH. 4. PARTICULAR CARE SHALL BE TAKEN TO AVOID CREATING HAZARDS ON THE PROJECT OR CAUSING DISRUPTION OF SERVICES REMAINING.
- 5. ALL EXISTING EQUIPMENT INDICATED TO BE REMOVED SHALL BE DONE IN A NEAT AND WORKMANLIKE MANNER. ALL EXISTING EQUIPMENT INDICATED TO BE TURNED OVER TO THE OWNER SHALL BE PRESENTED TO THE
- OWNER IN GOOD CONDITION AT A LOCATION DESIGNATED BY THE OWNER. ALL OTHER EQUIPMENT SHALL BE REMOVED FROM THE SITE. 6. REMOVE ALL ABANDONED CONDUCTORS AND EQUIPMENT NOT BUILT INTO THE BUILDING CONSTRUCTION. WHERE CEILING AND WALLS ARE
- REMOVED, ABANDONED WIRING SHALL BE REMOVED, AND ENDS OF LIVE SERVICES TO BE DISCONNECTED AND CUT-OFF.

 7. ABANDONED ELEMENTS BUILT INTO WALLS SHALL BE MARKED
- "ABANDONED". 8. E.C. SHALL RETAIN ALL LIGHTING CIRCUITS AND WIRING IN PLACE TO EXTEND TO NEW LIGHTING BEING INSTALLED.



EAST PROVIDENCE POLICE DEPT RENOVATIONS

750 WATERMAN AVE EAST PROVIDENCE, RI 02914

STATE PROJECT NUMBER < remove if not required>

JCJARCHITECTURE 120 HUYSHOPE AVENUE SUITE 400 HARTFORD, CT 06106


© 2023 JCJ Architecture

860.247.9226



GGD consulting engineers, inc. 375 Faunce Corner Road, Suite D, Dartmouth, MA 02747-1258 p: 508-998-5700 • f: 508-998-0883 • E-MAIL: info@g-g-d.com

CONSTRUCTION DOCUMENTS 06/03/2024

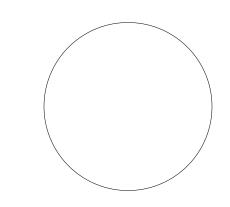

JOB __JCJ PROJECT NUMBER: B23036.00_ DRAWN_JR

SCALE As indicated

07/08/2024 Addendum 1

MAIN LEVEL - LIGHTING DEMO

ED-112

GENERAL DEMOLITION NOTES: MAINTAIN SUCH DOWNSTREAM DEVICES. RE-USED UNLESS SPECIFICALLY NOTED AS SUCH. 6. REMOVE ALL ABANDONED CONDUCTORS AND EQUIPMENT NOT BUILT INTO E.C. SHALL RETAIN ALL LIGHTING CIRCUITS AND WIRING IN PLACE TO EXTEND TO NEW LIGHTING BEING INSTALLED. 16 040 SALLYPORT B STAIR B 027 MALE LOCKERS

12

TRANSFER

001 VESTIBULE

034 MALE

CR XM

041 CORR

038 FEMALE

035 MALE

026 FEMALE LOCKERS

SWITCH-

EXISTING "MDP"

EXISTING PANEL "M"

029 CORRIDOR

027a

SHOWER

027b SUPERVISOR LOCKERS

002 MECHANICAL

-EXISTING HVAC DUCTWORK

EXISTING UTILITY METER

MECH
EXISTING PANEL "B"

EXISTING MAIN DISCONNECT

6 5

017 EVIDENCE PACKAGING

CR XM

CR XM

013 EVIDENCE

STORAGE

010 EVIDENCE

016 FORENSICS/ IT

019 SUPERVISOR

048 BCI

012 FUME

011 EVID PROCESS

A STAIR A

1 LOWER LEVEL FLOOR - ELECTRICAL DEMOLITION ED-211 SCALE: 3/16" = 1'-0"

CR X

X X X X

004 CORRIDOR

037 FEMALE

036 MALE

<u>C</u>

- REFER TO DEMOLITION SECTION OF SPECIFICATION FOR ADDITIONAL REQUIREMENTS.
- 2. WHERE DOWNSTREAM DEVICES ARE AFFECTED BY THE DEMOLITION WORK THIS CONTRACTOR SHALL PROVIDE NEW WIRING AS REQUIRED TO
- 3. ALL DEVICES AND/OR EQUIPMENT REMOVED BY THIS CONTRACTOR SHALL BE INSPECTED BY THE OWNER FOR DETERMINATION OF DISPOSAL OR STORAGE AS DIRECTED BY THE OWNER. FOR PURPOSES OF PRICING THIS CONTRACTOR SHALL ASSUME THAT NO DEVICE OR EQUIPMENT WILL BE
- 4. PARTICULAR CARE SHALL BE TAKEN TO AVOID CREATING HAZARDS ON THE PROJECT OR CAUSING DISRUPTION OF SERVICES REMAINING. 5. ALL EXISTING EQUIPMENT INDICATED TO BE REMOVED SHALL BE DONE IN A NEAT AND WORKMANLIKE MANNER. ALL EXISTING EQUIPMENT INDICATED
- TO BE TURNED OVER TO THE OWNER SHALL BE PRESENTED TO THE OWNER IN GOOD CONDITION AT A LOCATION DESIGNATED BY THE OWNER. ALL OTHER EQUIPMENT SHALL BE REMOVED FROM THE SITE.
- THE BUILDING CONSTRUCTION. WHERE CEILING AND WALLS ARE REMOVED, ABANDONED WIRING SHALL BE REMOVED, AND ENDS OF LIVE SERVICES TO BE DISCONNECTED AND CUT-OFF. 7. ABANDONED ELEMENTS BUILT INTO WALLS SHALL BE MARKED

EAST PROVIDENCE, RI 02914 STATE PROJECT NUMBER < remove if not required>

750 WATERMAN AVE

JCJARCHITECTURE 120 HUYSHOPE AVENUE SUITE 400

HARTFORD, CT 06106

EAST PROVIDENCE

POLICE DEPT

RENOVATIONS


© 2023 JCJ Architecture

860.247.9226



375 Faunce Corner Road, Suite D, Dartmouth, MA 02747-1258 p: 508-998-5700 • f: 508-998-0883 • E-MAIL: info@g-g-d.com

CONSTRUCTION DOCUMENTS 06/03/2024

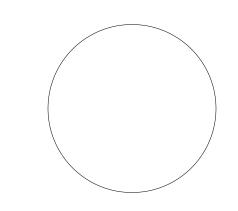

PIC [WHO] _____ DL [WHO] ____


ISSUE _ISSUE DATE_ JOB __JCJ PROJECT NUMBER: B23036.00_ DRAWN_JR

SCALE As indicated REVISIONS

07/08/2024 Addendum 1

LOWER LEVEL - ELECTRICAL DEMOLITION PLAN

ED-211

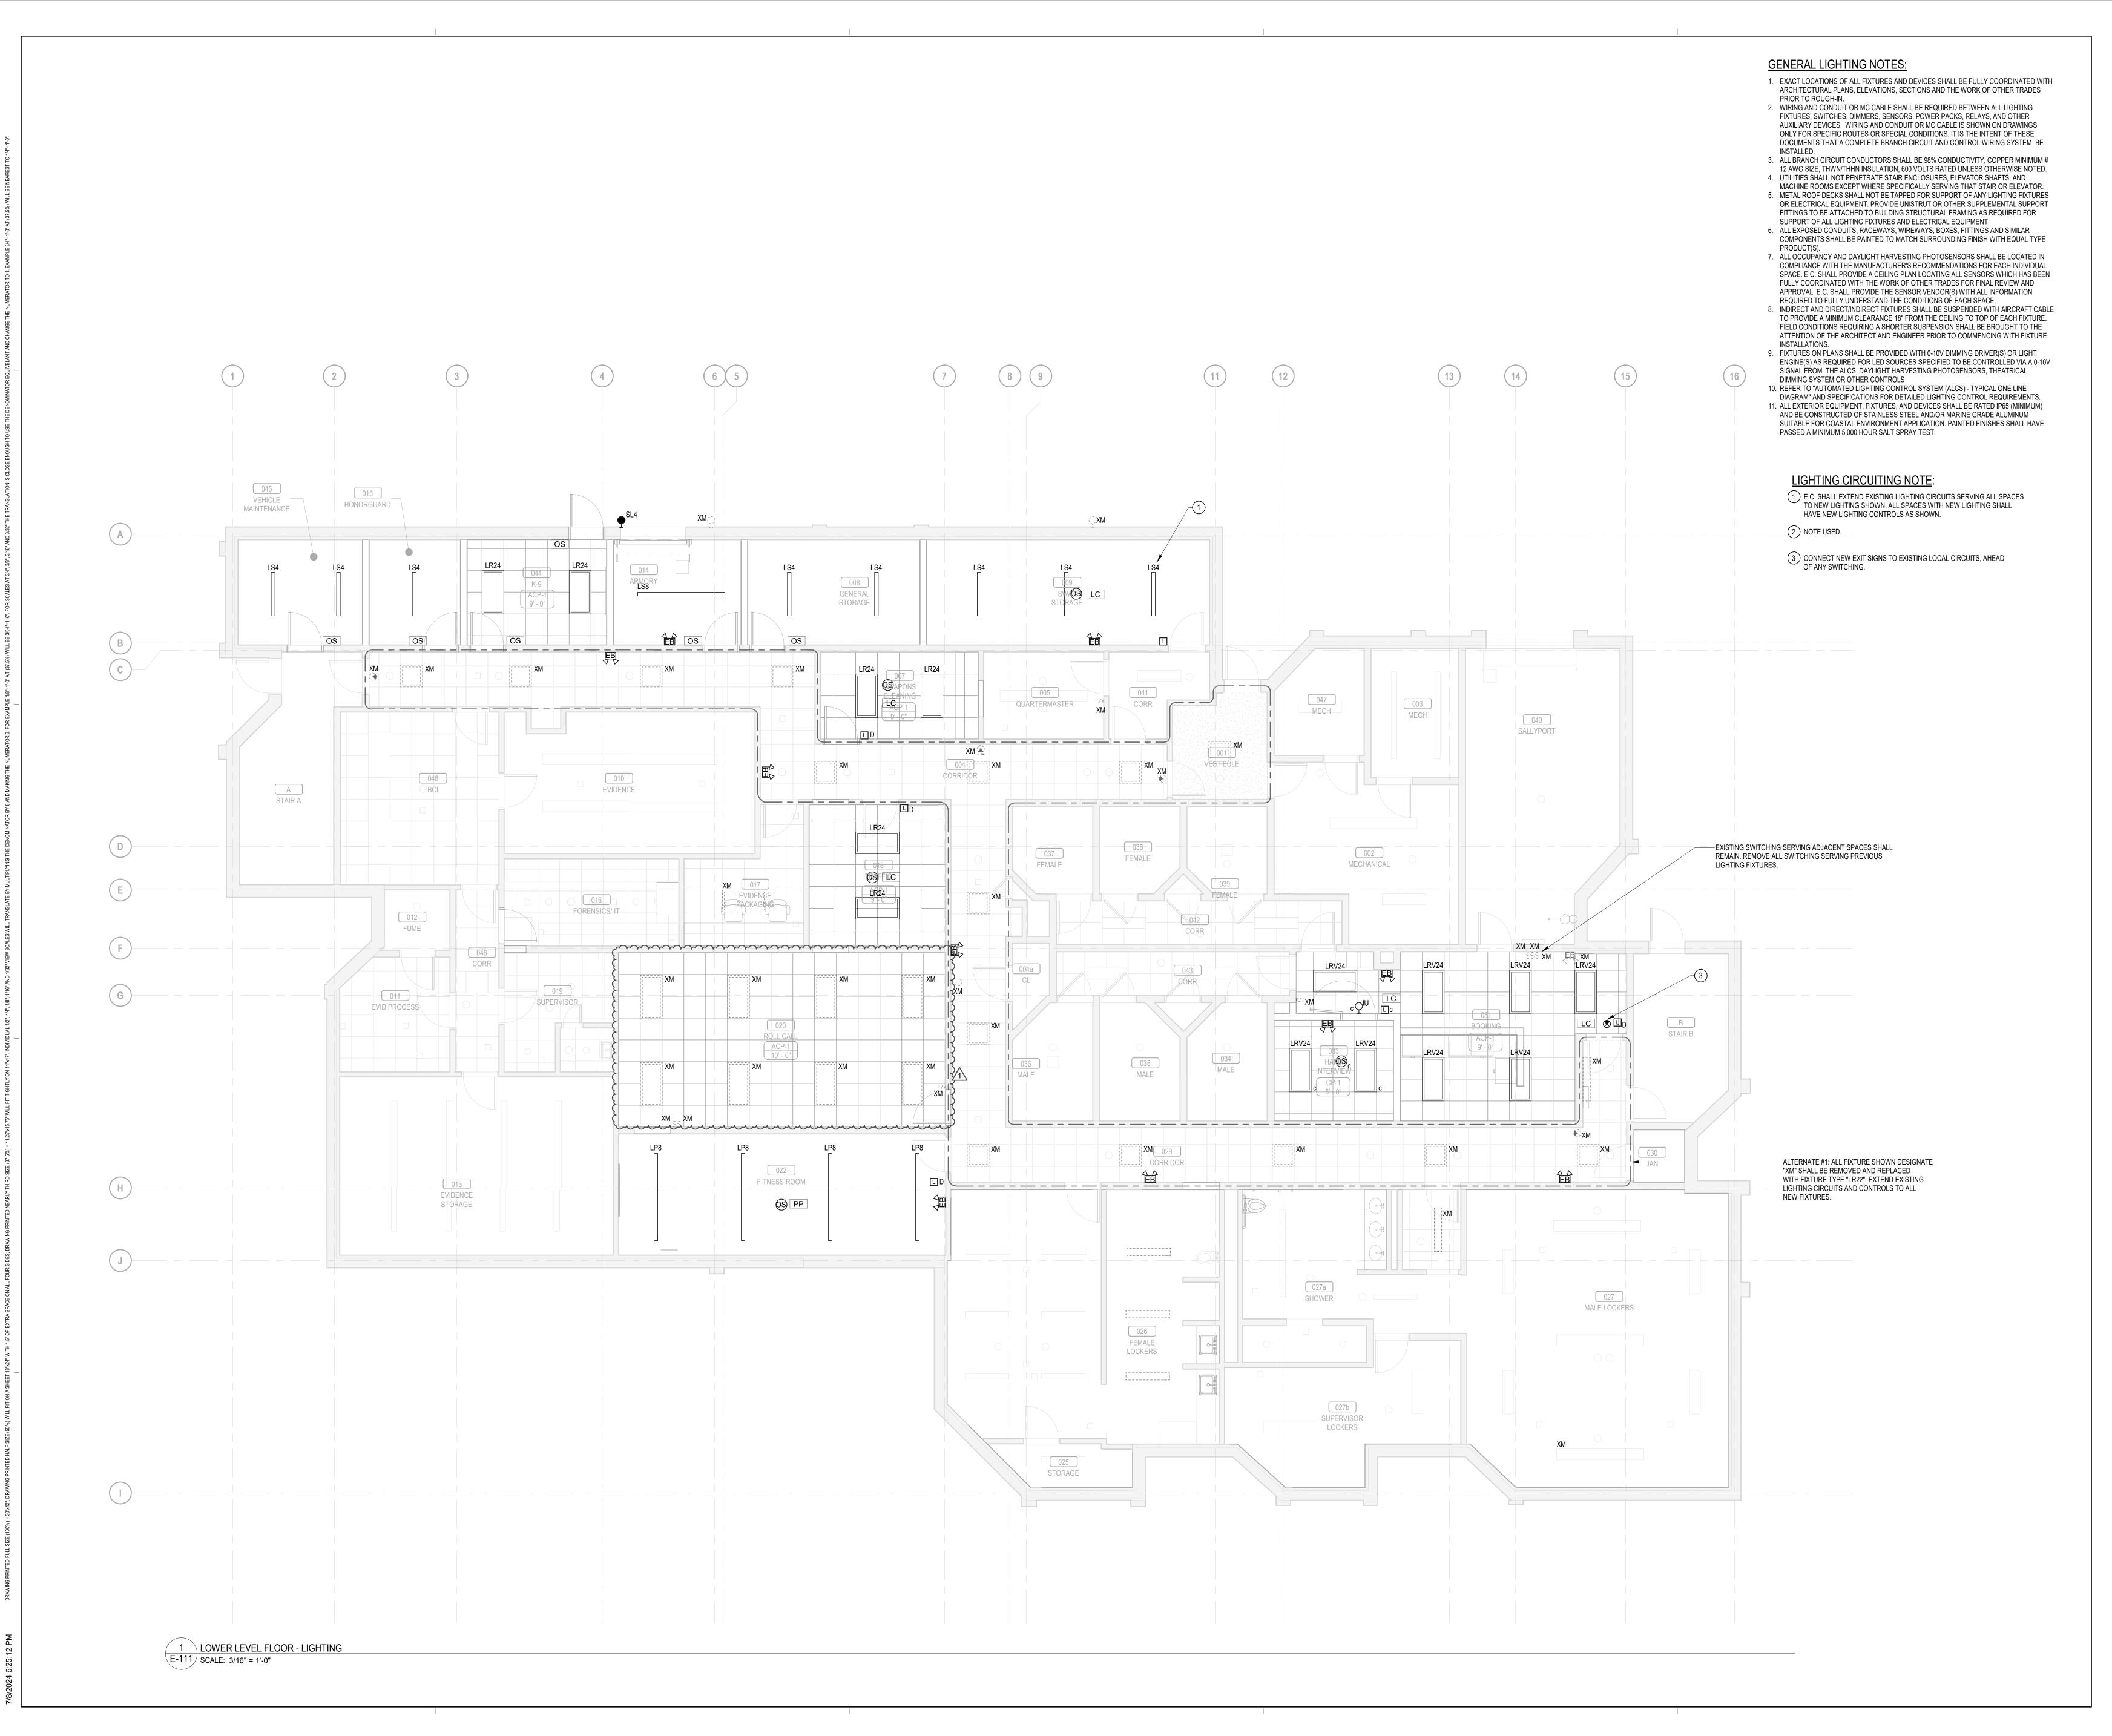

750 WATERMAN AVE East Providence, RI 02914

STATE PROJECT NUMBER < remove if not required>

JCJARCHITECTURE

120 HUYSHOPE AVENUE
SUITE 400
HARTFORD, CT 06106


© 2023 JCJ Architecture

860.247.9226



GGD CONSULTING ENGINEERS, INC. 375 Faunce Corner Road, Suite D, Dartmouth, MA 02747-1258 p: 508-998-5700 • f: 508-998-0883 • E-MAIL: info@g-g-d.com

CONSTRUCTION DOCUMENTS 06/03/2024

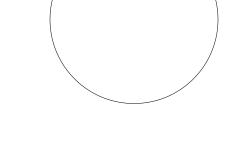

PIC [WHO] _____ DL [WHO] ___ PM [WHO] ____ DTL [WHO] ___

ISSUE ISSUE DATE


JOB JCJ PROJECT NUMBER: B23036.00

DRAWN JR

SCALE As indicated
REVISIONS

07/08/2024 Addendum 1

LOWER LEVEL - LIGHTING PLAN

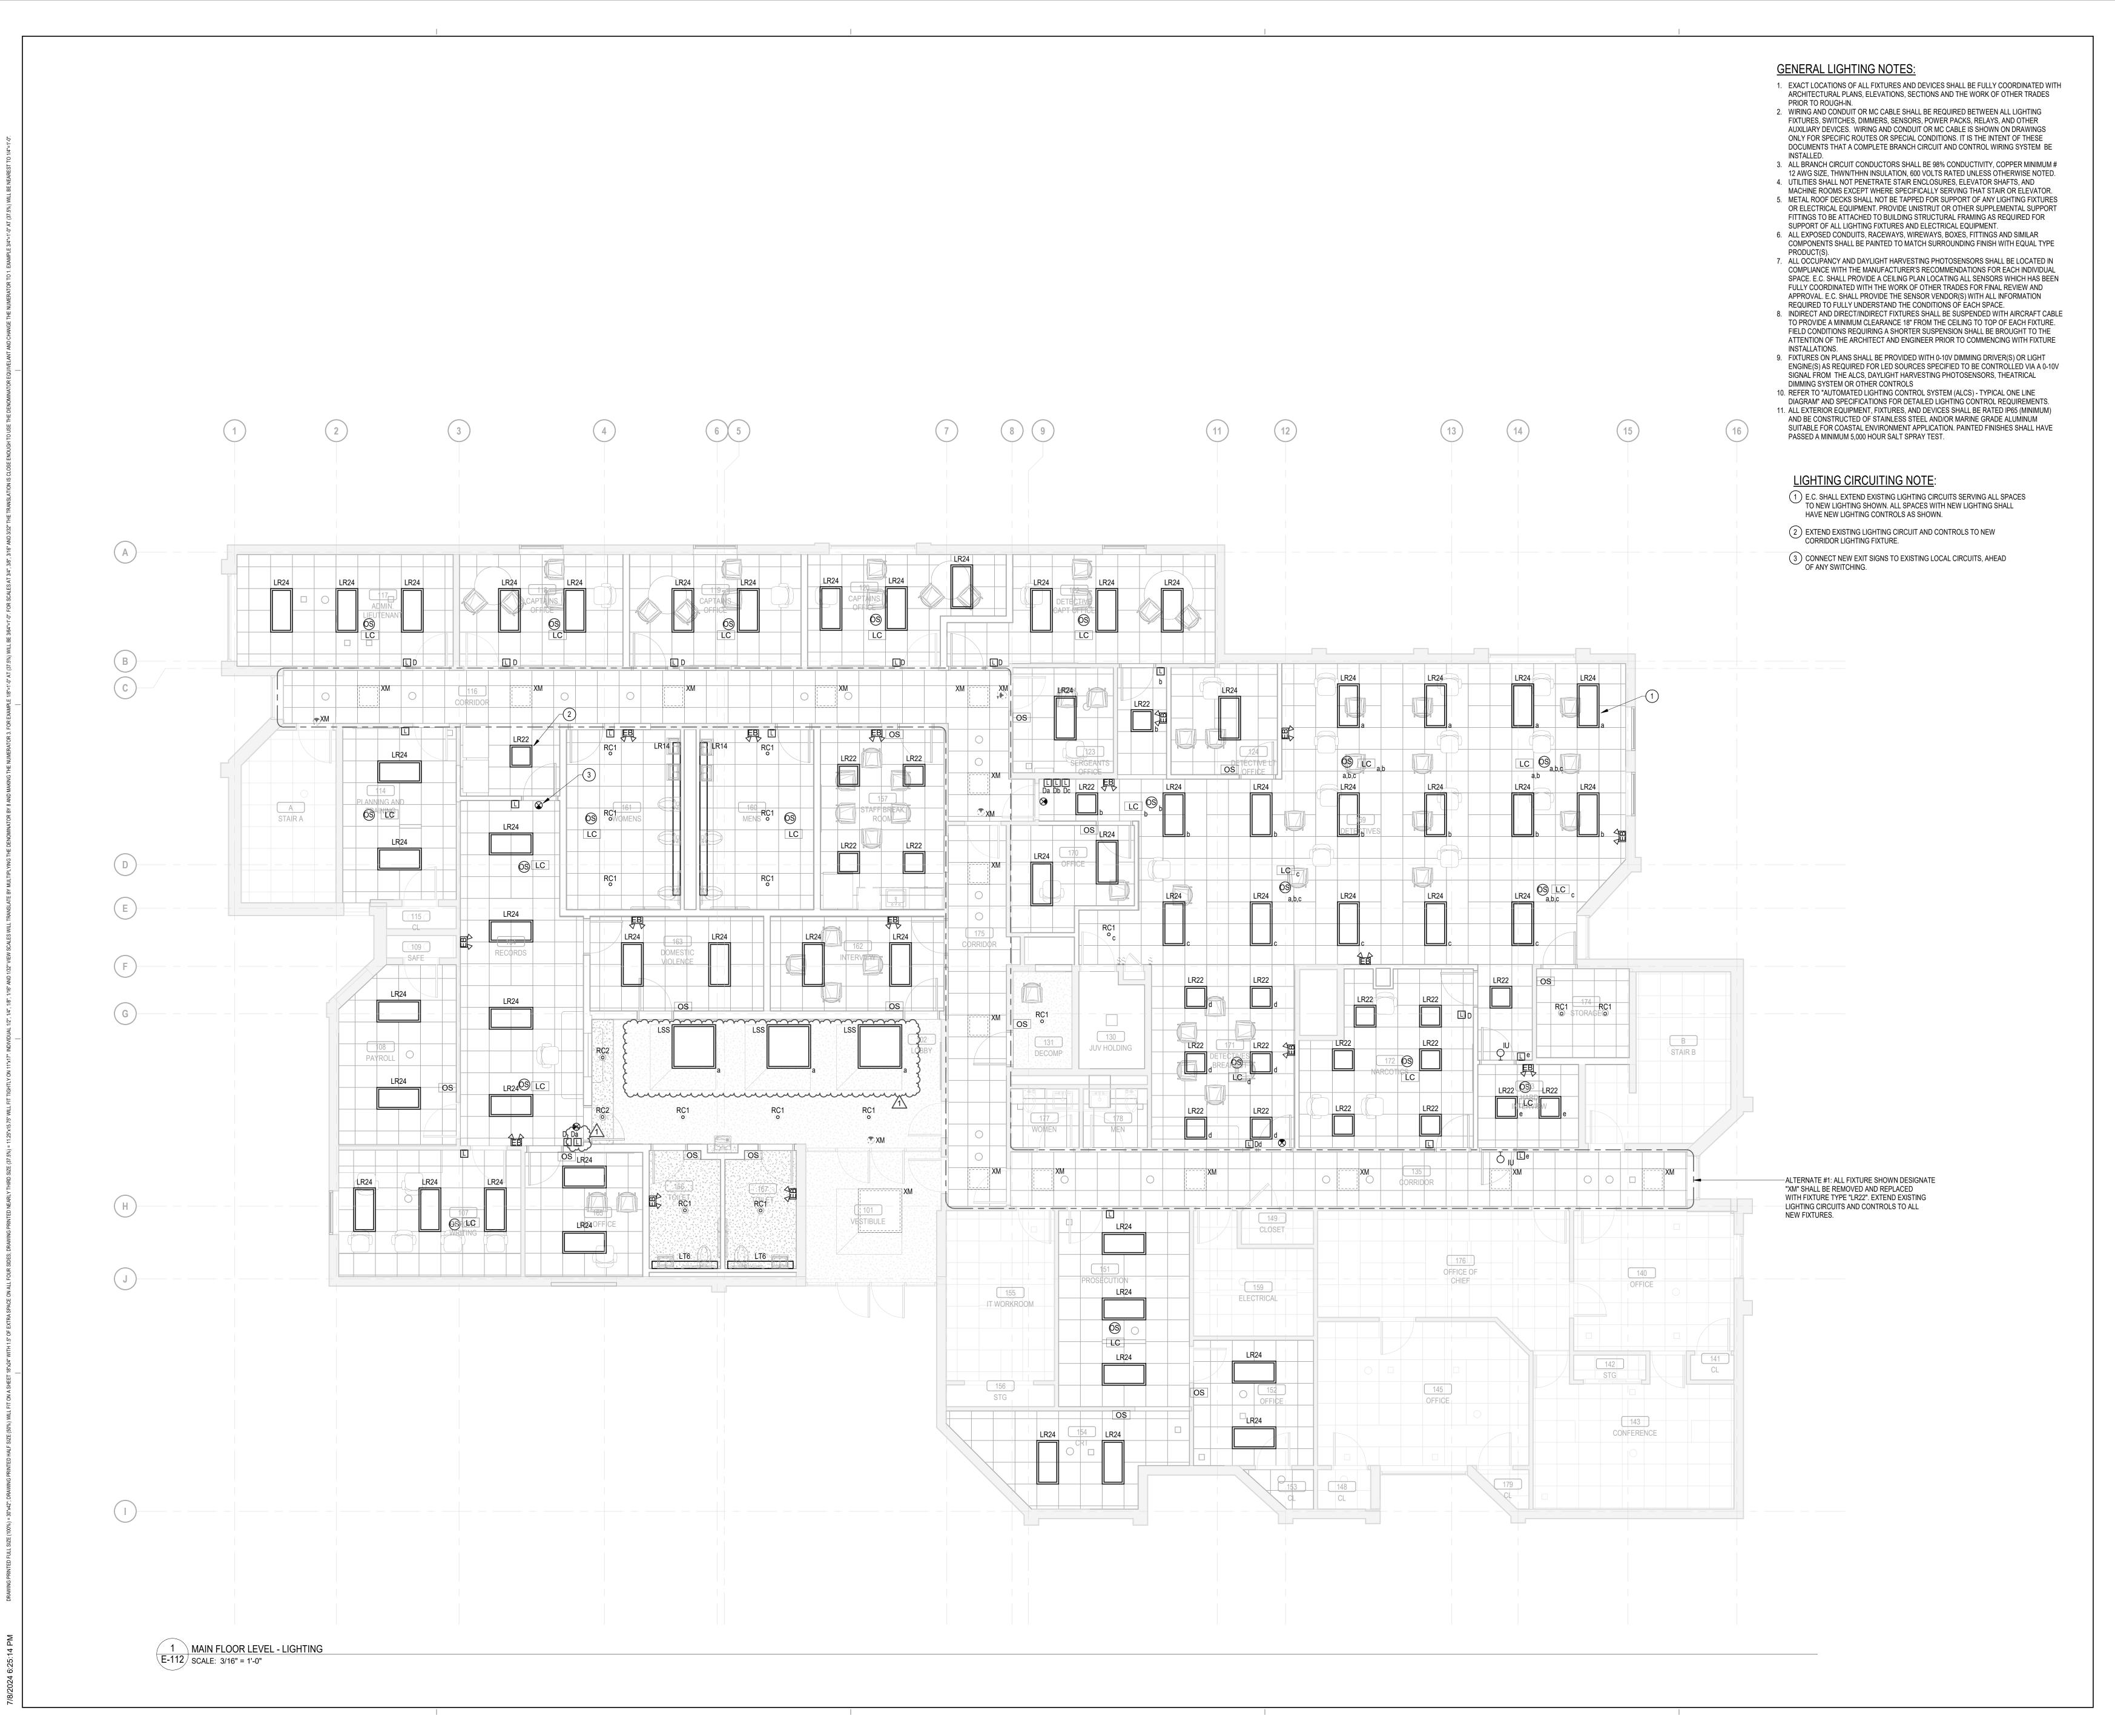

750 WATERMAN AVE EAST PROVIDENCE, RI 02914

STATE PROJECT NUMBER < remove if not required>

JCJARCHITECTURE

120 HUYSHOPE AVENUE
SUITE 400
HARTFORD, CT 06106


© 2023 JCJ Architecture

860.247.9226



GGD CONSULTING ENGINEERS, INC. 375 Faunce Corner Road, Suite D, Dartmouth, MA 02747-1258 p: 508-998-5700 • f: 508-998-0883 • E-MAIL: info@g-g-d.com

CONSTRUCTION DOCUMENTS 06/03/2024

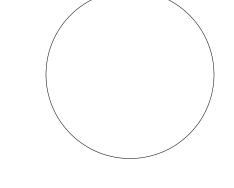


PIC [WHO] _____ DL [WHO] ___ PM [WHO] DTL [WHO]

ISSUE __ISSUE DATE_ JOB __JCJ PROJECT NUMBER: B23036.00_ DRAWN __JR

SCALE As indicated
REVISIONS

07/08/2024 Addendum 1

MAIN LEVEL - LIGHTING PLAN

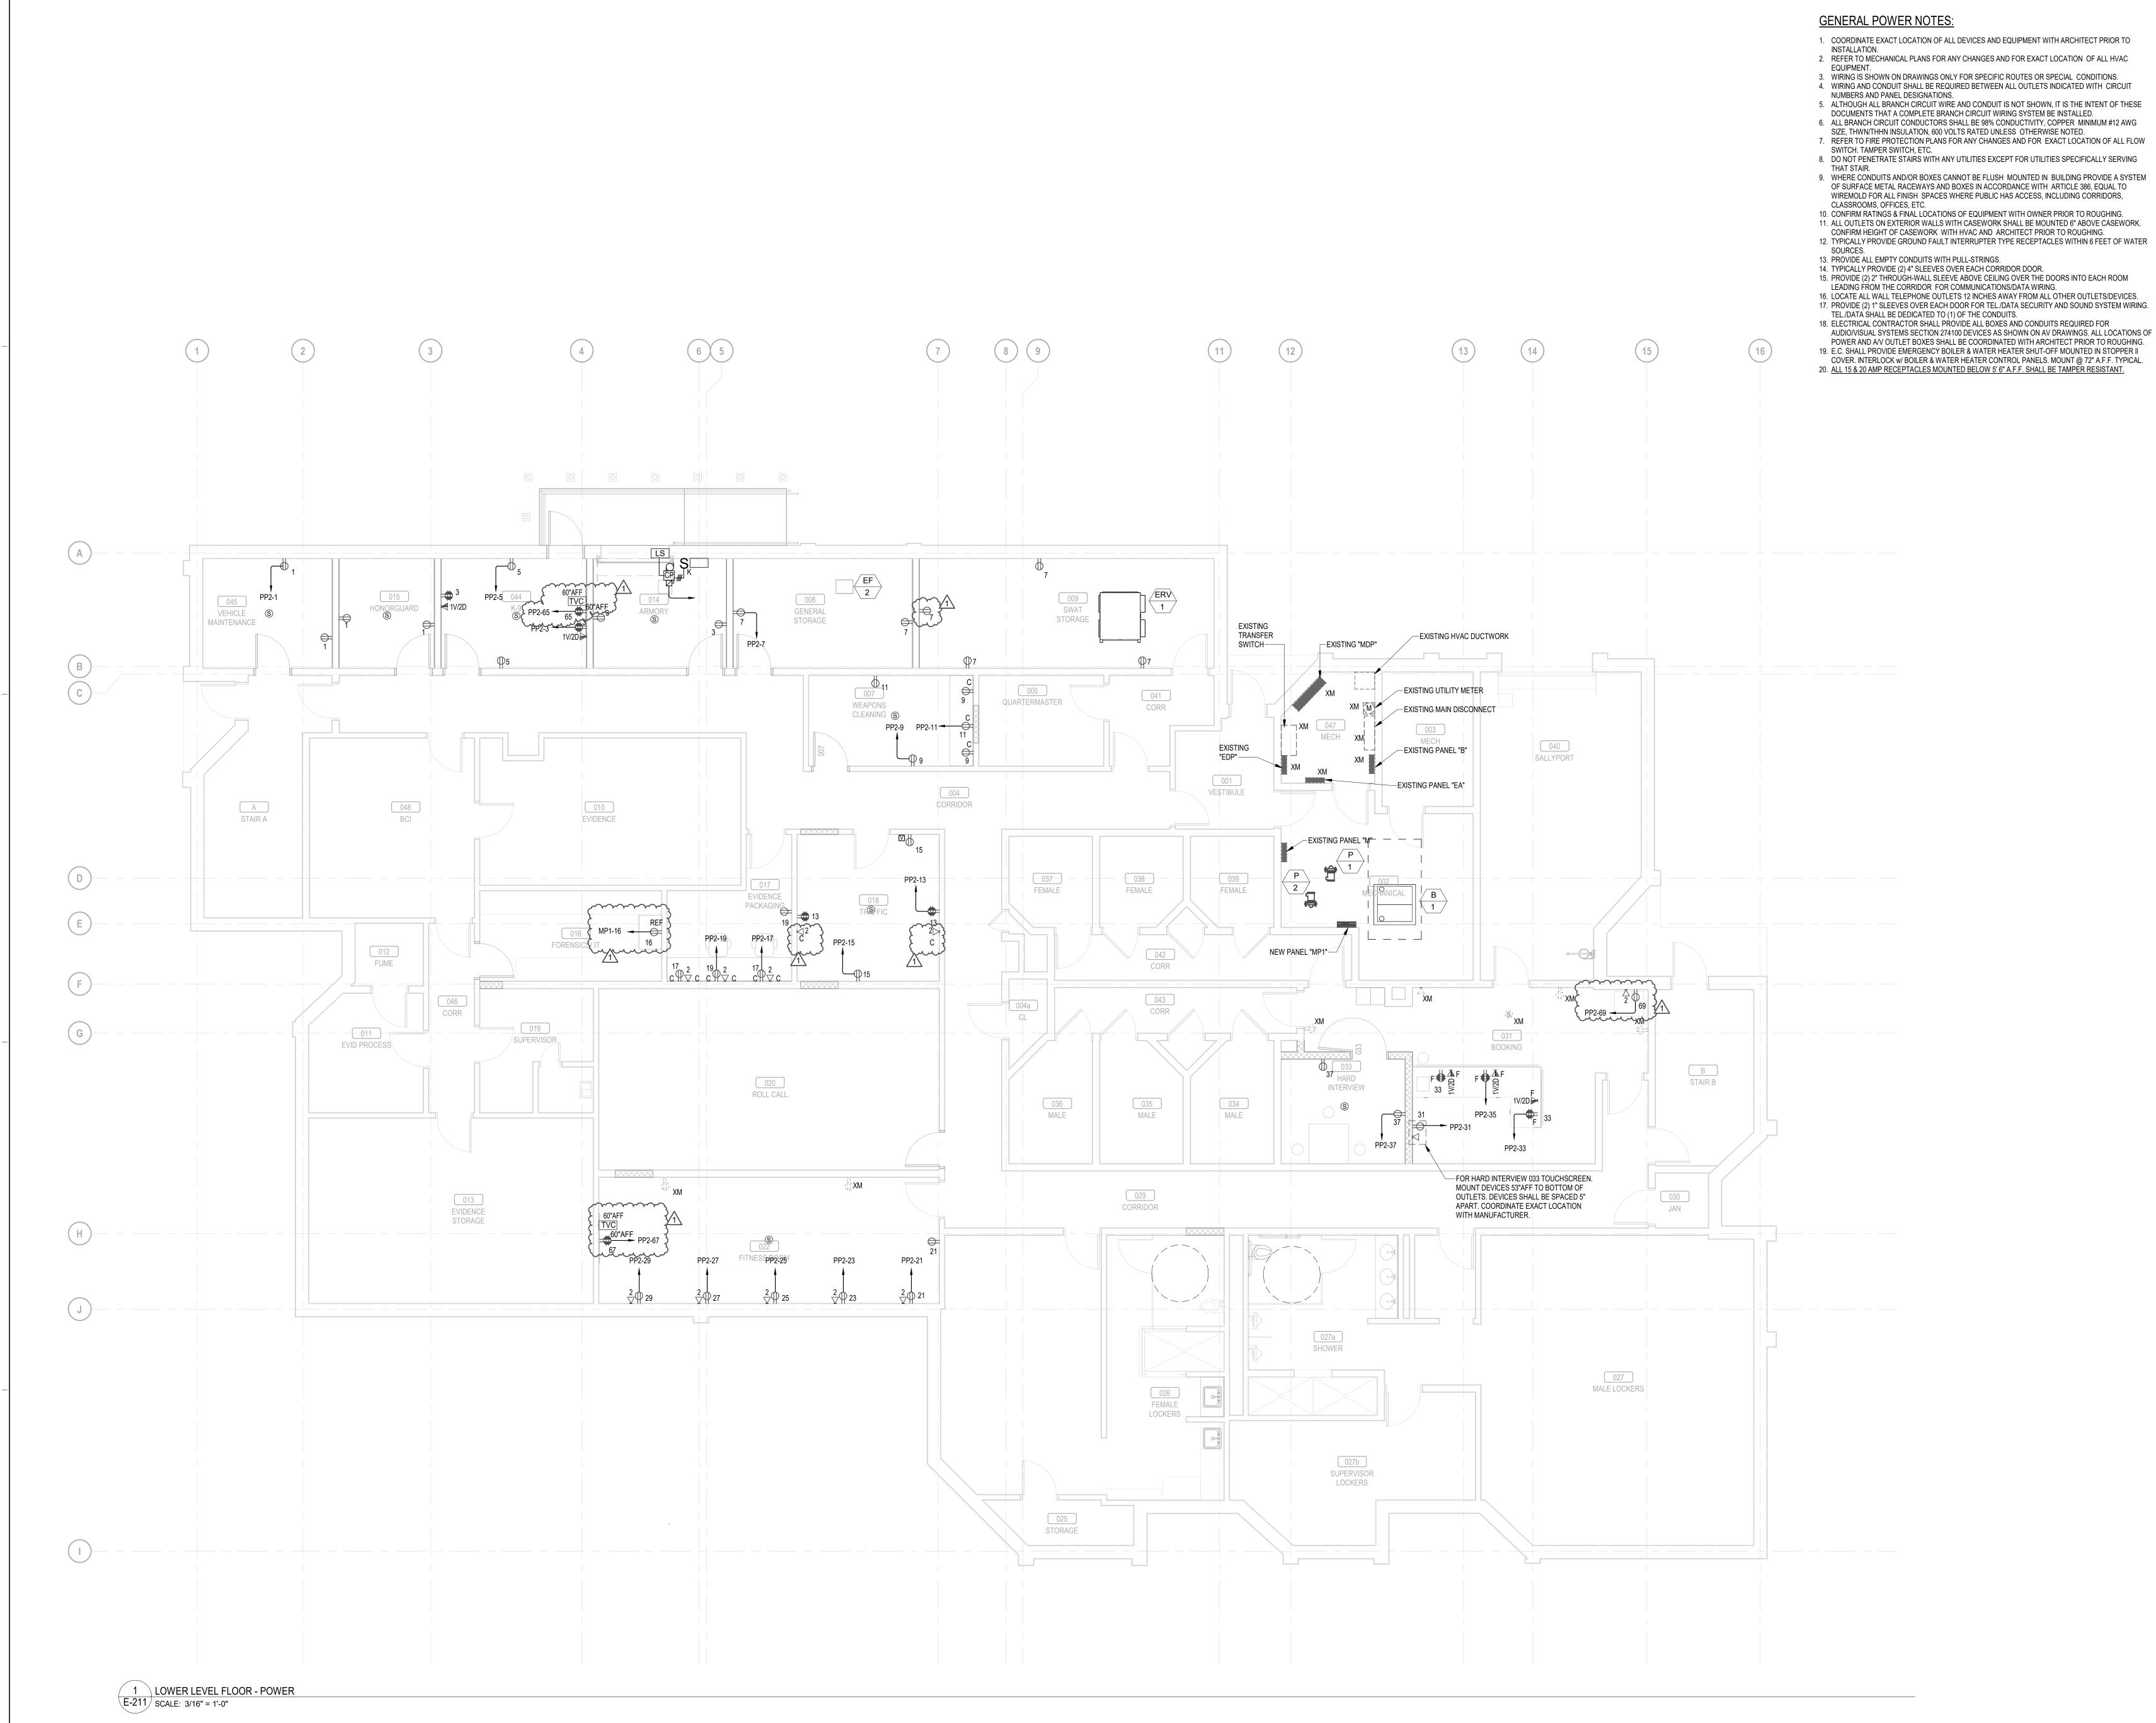

- 1. COORDINATE EXACT LOCATION OF ALL DEVICES AND EQUIPMENT WITH ARCHITECT PRIOR TO
- 2. REFER TO MECHANICAL PLANS FOR ANY CHANGES AND FOR EXACT LOCATION OF ALL HVAC
- 4. WIRING AND CONDUIT SHALL BE REQUIRED BETWEEN ALL OUTLETS INDICATED WITH CIRCUIT
- 5. ALTHOUGH ALL BRANCH CIRCUIT WIRE AND CONDUIT IS NOT SHOWN, IT IS THE INTENT OF THESE DOCUMENTS THAT A COMPLETE BRANCH CIRCUIT WIRING SYSTEM BE INSTALLED.
- 6. ALL BRANCH CIRCUIT CONDUCTORS SHALL BE 98% CONDUCTIVITY, COPPER MINIMUM #12 AWG SIZE, THWN/THHN INSULATION, 600 VOLTS RATED UNLESS OTHERWISE NOTED. 7. REFER TO FIRE PROTECTION PLANS FOR ANY CHANGES AND FOR EXACT LOCATION OF ALL FLOW
- 8. DO NOT PENETRATE STAIRS WITH ANY UTILITIES EXCEPT FOR UTILITIES SPECIFICALLY SERVING
- 9. WHERE CONDUITS AND/OR BOXES CANNOT BE FLUSH MOUNTED IN BUILDING PROVIDE A SYSTEM OF SURFACE METAL RACEWAYS AND BOXES IN ACCORDANCE WITH ARTICLE 386, EQUAL TO
- 10. CONFIRM RATINGS & FINAL LOCATIONS OF EQUIPMENT WITH OWNER PRIOR TO ROUGHING. 11. ALL OUTLETS ON EXTERIOR WALLS WITH CASEWORK SHALL BE MOUNTED 6" ABOVE CASEWORK.
- CONFIRM HEIGHT OF CASEWORK WITH HVAC AND ARCHITECT PRIOR TO ROUGHING. 12. TYPICALLY PROVIDE GROUND FAULT INTERRUPTER TYPE RECEPTACLES WITHIN 6 FEET OF WATER
- 14. TYPICALLY PROVIDE (2) 4" SLEEVES OVER EACH CORRIDOR DOOR. 15. PROVIDE (2) 2" THROUGH-WALL SLEEVE ABOVE CEILING OVER THE DOORS INTO EACH ROOM
- 16. LOCATE ALL WALL TELEPHONE OUTLETS 12 INCHES AWAY FROM ALL OTHER OUTLETS/DEVICES.
- 18. ELECTRICAL CONTRACTOR SHALL PROVIDE ALL BOXES AND CONDUITS REQUIRED FOR
- POWER AND A/V OUTLET BOXES SHALL BE COORDINATED WITH ARCHITECT PRIOR TO ROUGHING. 19. E.C. SHALL PROVIDE EMERGENCY BOILER & WATER HEATER SHUT-OFF MOUNTED IN STOPPER II
- COVER. INTERLOCK w/ BOILER & WATER HEATER CONTROL PANELS. MOUNT @ 72" A.F.F. TYPICAL. 20. ALL 15 & 20 AMP RECEPTACLES MOUNTED BELOW 5' 6" A.F.F. SHALL BE TAMPER RESISTANT.

750 WATERMAN AVE EAST PROVIDENCE, RI 02914

POLICE DEPT

RENOVATIONS

JCJARCHITECTURE 120 HUYSHOPE AVENUE

STATE PROJECT NUMBER < remove if not required>

EAST PROVIDENCE


SUITE 400 HARTFORD, CT 06106 860.247.9226

© 2023 JCJ Architecture



375 Faunce Corner Road, Suite D, Dartmouth, MA 02747-1258 p: 508-998-5700 • f: 508-998-0883 • E-MAIL: info@g-g-d.com

CONSTRUCTION DOCUMENTS 06/03/2024

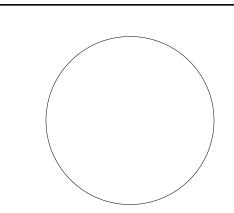

PIC [WHO] _____ DL [WHO] ____


ISSUE _ISSUE DATE_ JOB __JCJ PROJECT NUMBER: B23036.00_

DRAWN_JR SCALE As indicated

REVISIONS

07/08/2024 Addendum 1

LOWER LEVEL - POWER PLAN

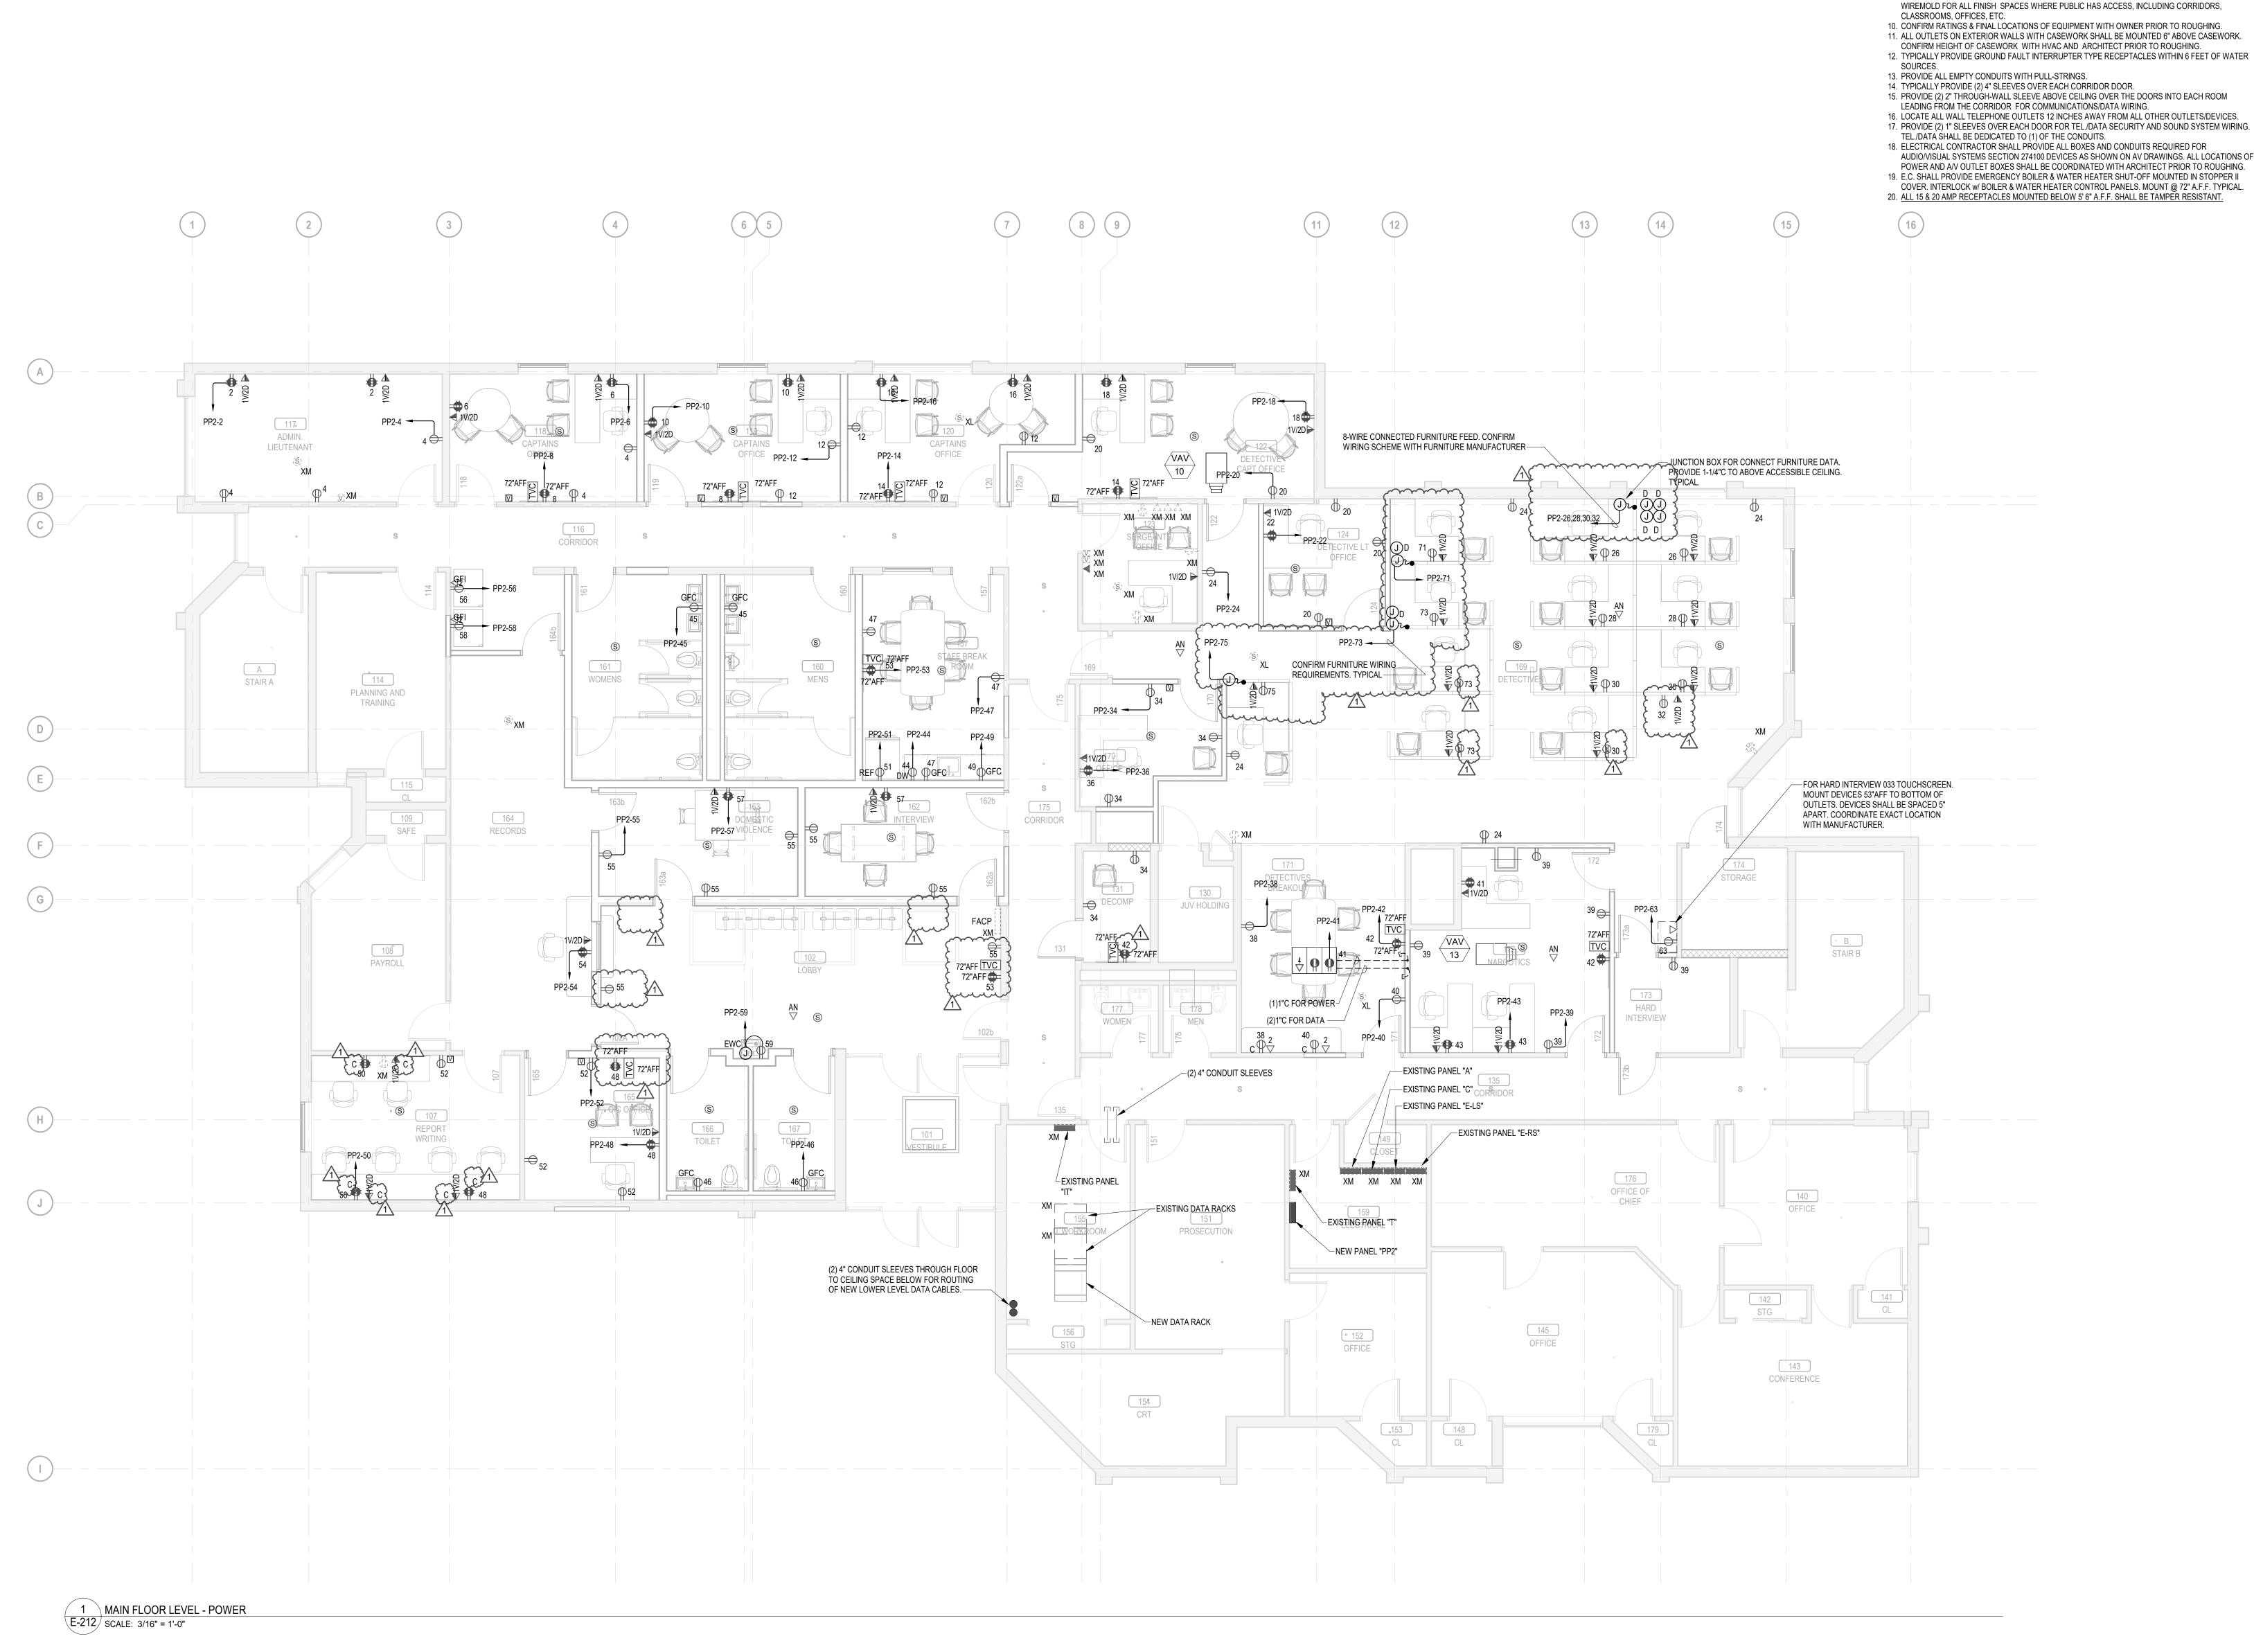

GENERAL POWER NOTES:

- 1. COORDINATE EXACT LOCATION OF ALL DEVICES AND EQUIPMENT WITH ARCHITECT PRIOR TO 2. REFER TO MECHANICAL PLANS FOR ANY CHANGES AND FOR EXACT LOCATION OF ALL HVAC EQUIPMENT.
- WIRING IS SHOWN ON DRAWINGS ONLY FOR SPECIFIC ROUTES OR SPECIAL CONDITIONS.
 WIRING AND CONDUIT SHALL BE REQUIRED BETWEEN ALL OUTLETS INDICATED WITH CIRCUIT NUMBERS AND PANEL DESIGNATIONS. 5. ALTHOUGH ALL BRANCH CIRCUIT WIRE AND CONDUIT IS NOT SHOWN, IT IS THE INTENT OF THESE
- DOCUMENTS THAT A COMPLETE BRANCH CIRCUIT WIRING SYSTEM BE INSTALLED. 6. ALL BRANCH CIRCUIT CONDUCTORS SHALL BE 98% CONDUCTIVITY, COPPER MINIMUM #12 AWG SIZE, THWN/THHN INSULATION, 600 VOLTS RATED UNLESS OTHERWISE NOTED. 7. REFER TO FIRE PROTECTION PLANS FOR ANY CHANGES AND FOR EXACT LOCATION OF ALL FLOW
- 8. DO NOT PENETRATE STAIRS WITH ANY UTILITIES EXCEPT FOR UTILITIES SPECIFICALLY SERVING THAT STAIR. 9. WHERE CONDUITS AND/OR BOXES CANNOT BE FLUSH MOUNTED IN BUILDING PROVIDE A SYSTEM OF SURFACE METAL RACEWAYS AND BOXES IN ACCORDANCE WITH ARTICLE 386, EQUAL TO WIREMOLD FOR ALL FINISH SPACES WHERE PUBLIC HAS ACCESS, INCLUDING CORRIDORS,

SWITCH. TAMPER SWITCH, ETC.

- 11. ALL OUTLETS ON EXTERIOR WALLS WITH CASEWORK SHALL BE MOUNTED 6" ABOVE CASEWORK. CONFIRM HEIGHT OF CASEWORK WITH HVAC AND ARCHITECT PRIOR TO ROUGHING.
- 12. TYPICALLY PROVIDE GROUND FAULT INTERRUPTER TYPE RECEPTACLES WITHIN 6 FEET OF WATER
- 15. PROVIDE (2) 2" THROUGH-WALL SLEEVE ABOVE CEILING OVER THE DOORS INTO EACH ROOM LEADING FROM THE CORRIDOR FOR COMMUNICATIONS/DATA WIRING. 16. LOCATE ALL WALL TELEPHONE OUTLETS 12 INCHES AWAY FROM ALL OTHER OUTLETS/DEVICES.
- 18. ELECTRICAL CONTRACTOR SHALL PROVIDE ALL BOXES AND CONDUITS REQUIRED FOR AUDIO/VISUAL SYSTEMS SECTION 274100 DEVICES AS SHOWN ON AV DRAWINGS. ALL LOCATIONS OF POWER AND A/V OUTLET BOXES SHALL BE COORDINATED WITH ARCHITECT PRIOR TO ROUGHING.

120 HUYSHOPE AVENUE SUITE 400 HARTFORD, CT 06106 860.247.9226

JCJARCHITECTURE

EAST PROVIDENCE

POLICE DEPT

RENOVATIONS

750 WATERMAN AVE

EAST PROVIDENCE, RI 02914

STATE PROJECT NUMBER < remove if not required>


© 2023 JCJ Architecture

CONSULTANT:



375 Faunce Corner Road, Suite D, Dartmouth, MA 02747-1258 p: 508-998-5700 • f: 508-998-0883 • E-MAIL: info@g-g-d.com

> CONSTRUCTION DOCUMENTS 06/03/2024

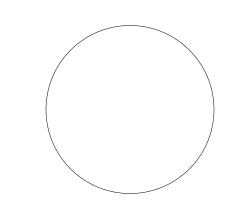

PIC [WHO] _____ DL [WHO] ____

ISSUE _ISSUE DATE JOB __JCJ PROJECT NUMBER: B23036.00 DRAWN_JR

SCALE As indicated


REVISIONS 07/08/2024 Addendum 1

MAIN LEVEL - POWER PLAN

GENERAL SECURITY NOTES:

- 1. PROVIDE CORNER MOUNTED MOTION SENSOR WHENEVER
- 2. IESS TO COORDINATE FINAL SECURITY ZONES WITH OWNER.
 PROGRAM PER OWNER'S DIRECTIONS.
 3. COORDINATE FINAL LOCATIONS OF MAGNETIC DOOR HOLDERS AND
 OTHER HARDWARE DEVICES WITH HARDWARE SUPPLIER PRIOR TO
- ROUGHING.

 4. SECURITY PANIC SWITCH. DOOR SHALL REMAIN SECURED UPON ACTIVATION OF PANIC STATION. SECURITY PERSONEL SHALL BE
- NOTIFIED.
- 5. INTERFACE HANDICAP DOOR CONTROLLER WITH RESPECTIVE ACCESS CONTROL HARDWARE AT EACH DOOR WITH EITHER POWER ASSIST OR HANDICAP PUSH PLATE.

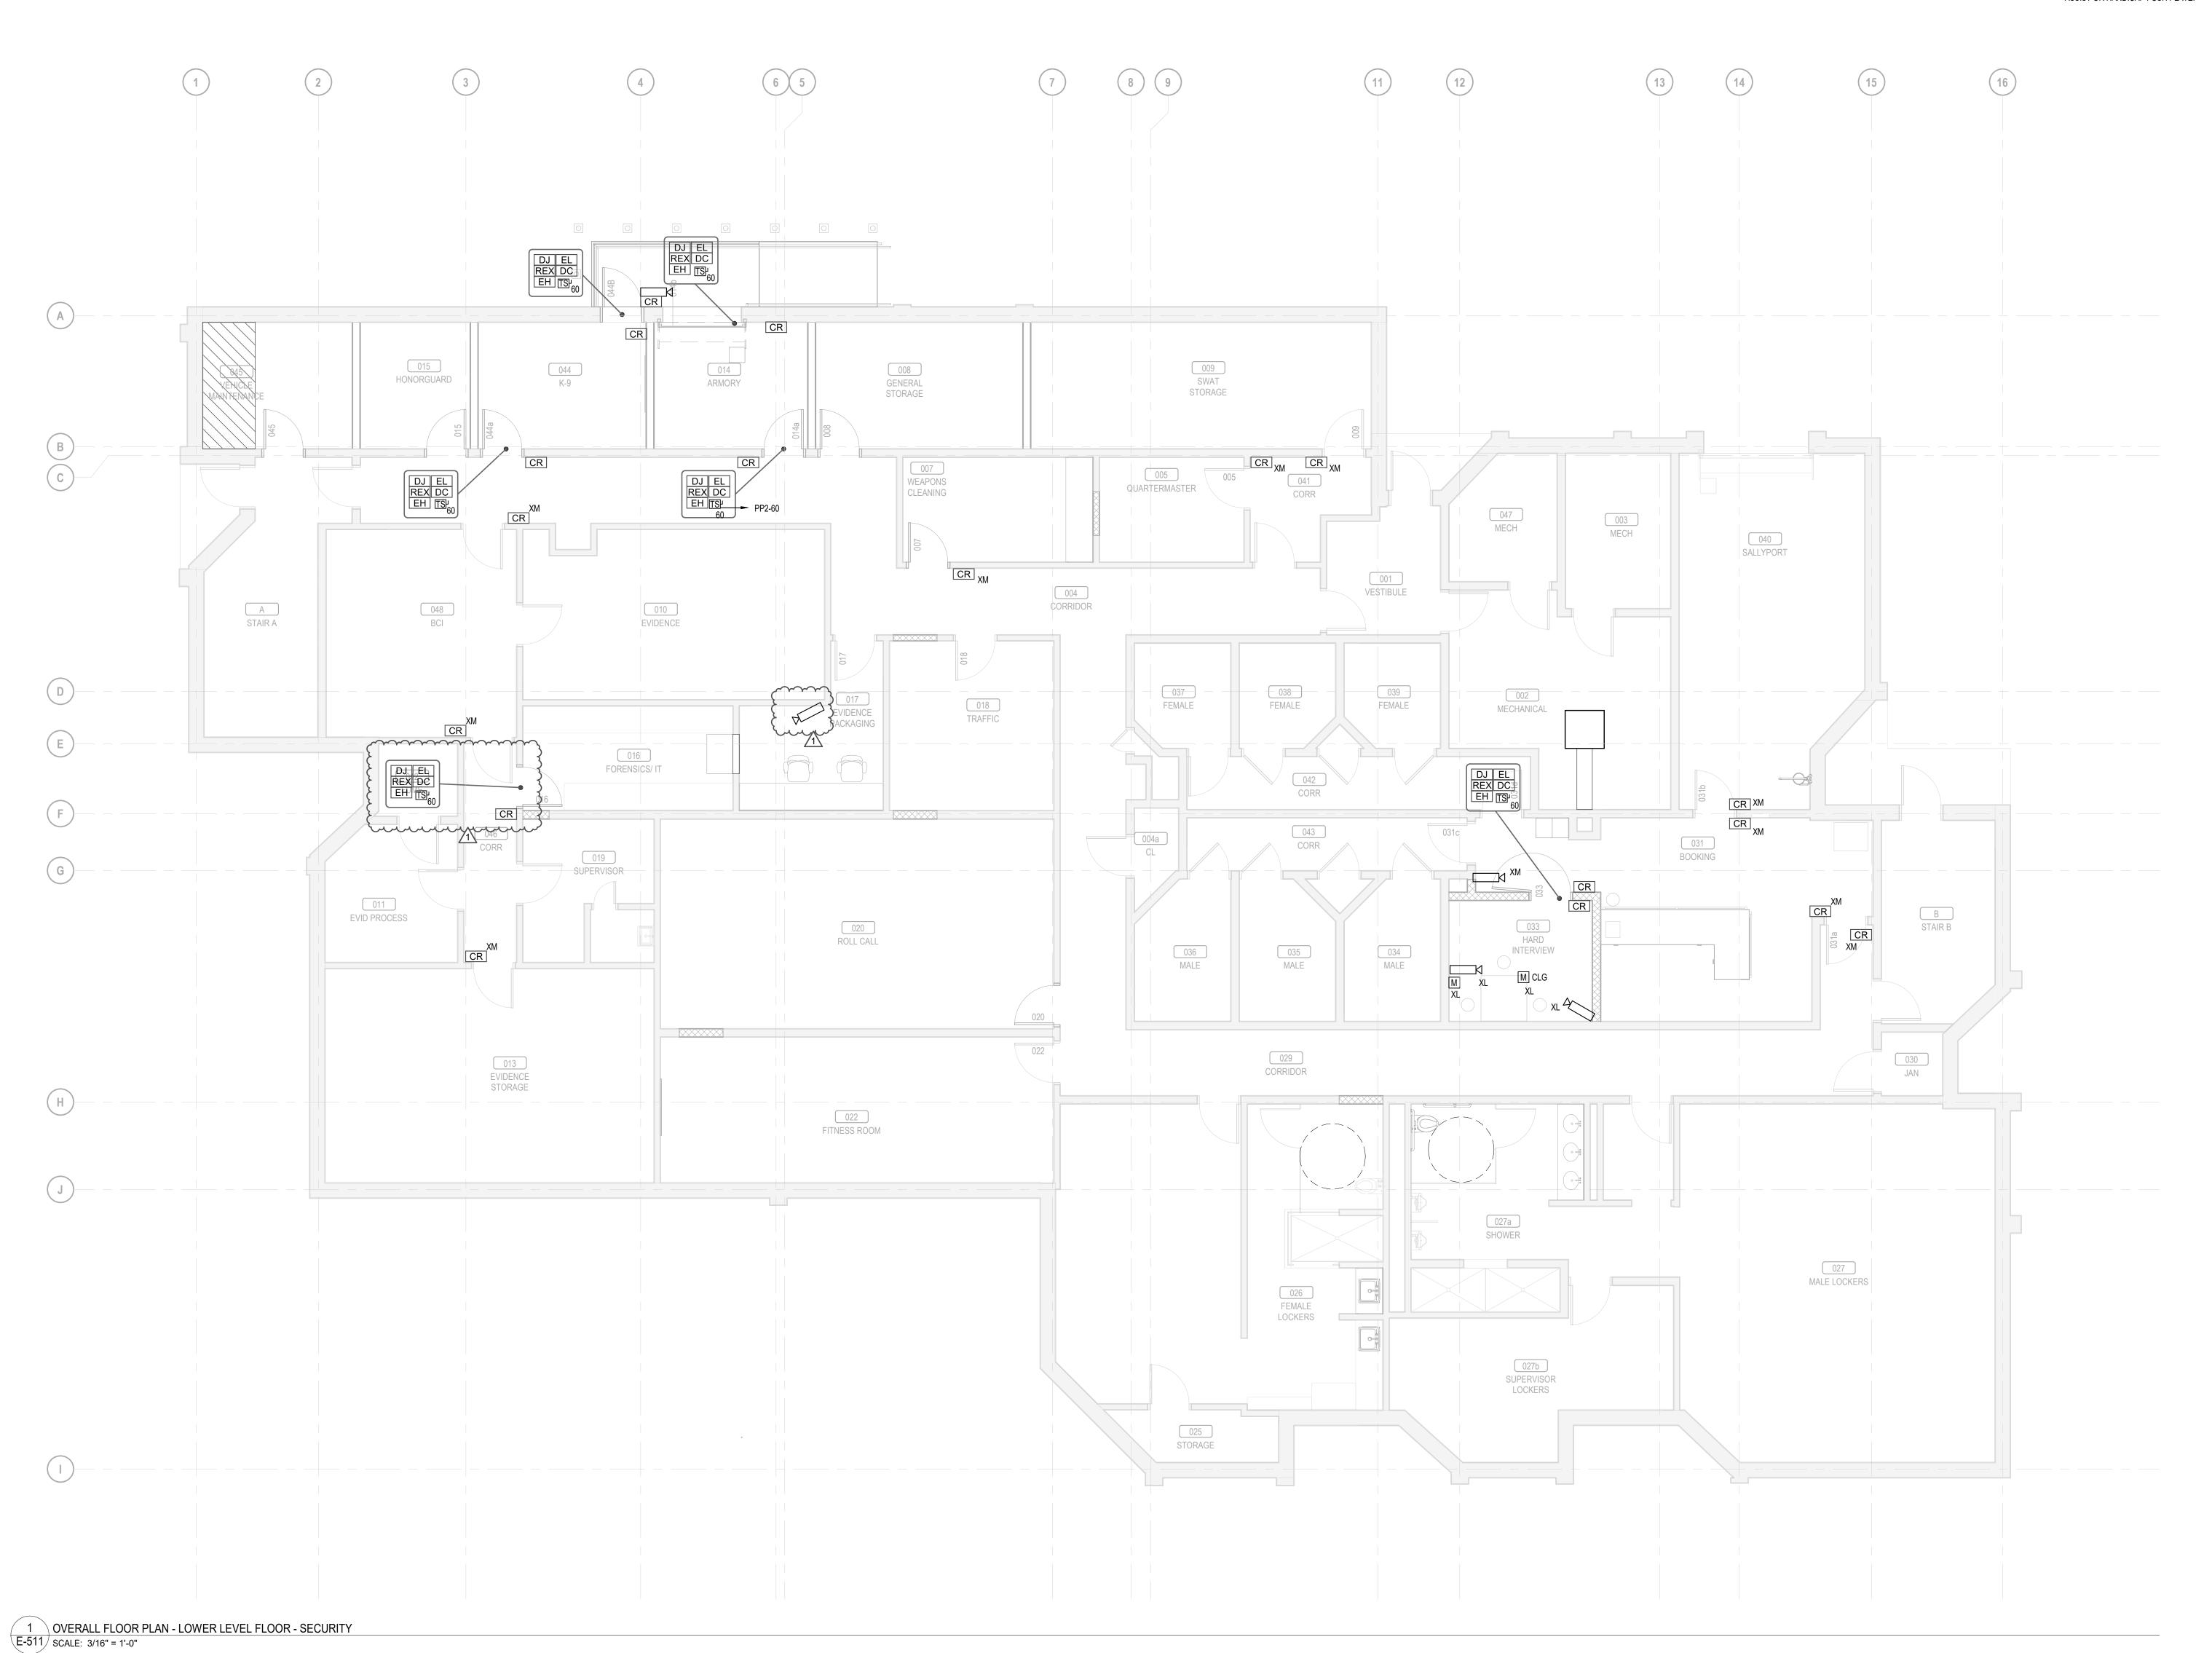

EAST PROVIDENCE POLICE DEPT RENOVATIONS

750 WATERMAN AVE EAST PROVIDENCE, RI 02914

STATE PROJECT NUMBER < remove if not required>


JCJARCHITECTURE 120 HUYSHOPE AVENUE SUITE 400 HARTFORD, CT 06106 860.247.9226

© 2023 JCJ Architecture



GGD consulting engineers, inc. 375 Faunce Corner Road, Suite D, Dartmouth, MA 02747-1258 p: 508-998-5700 • f: 508-998-0883 • E-MAIL: info@g-g-d.com

CONSTRUCTION DOCUMENTS 06/03/2024

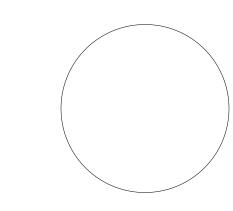


PIC [WHO] _____ DL [WHO] ____

ISSUE _ISSUE DATE_ JOB __JCJ PROJECT NUMBER: B23036.00_

DRAWN_JR SCALE As indicated

REVISIONS 07/08/2024 Addendum 1

LOWER LEVEL - SECURITY PLAN

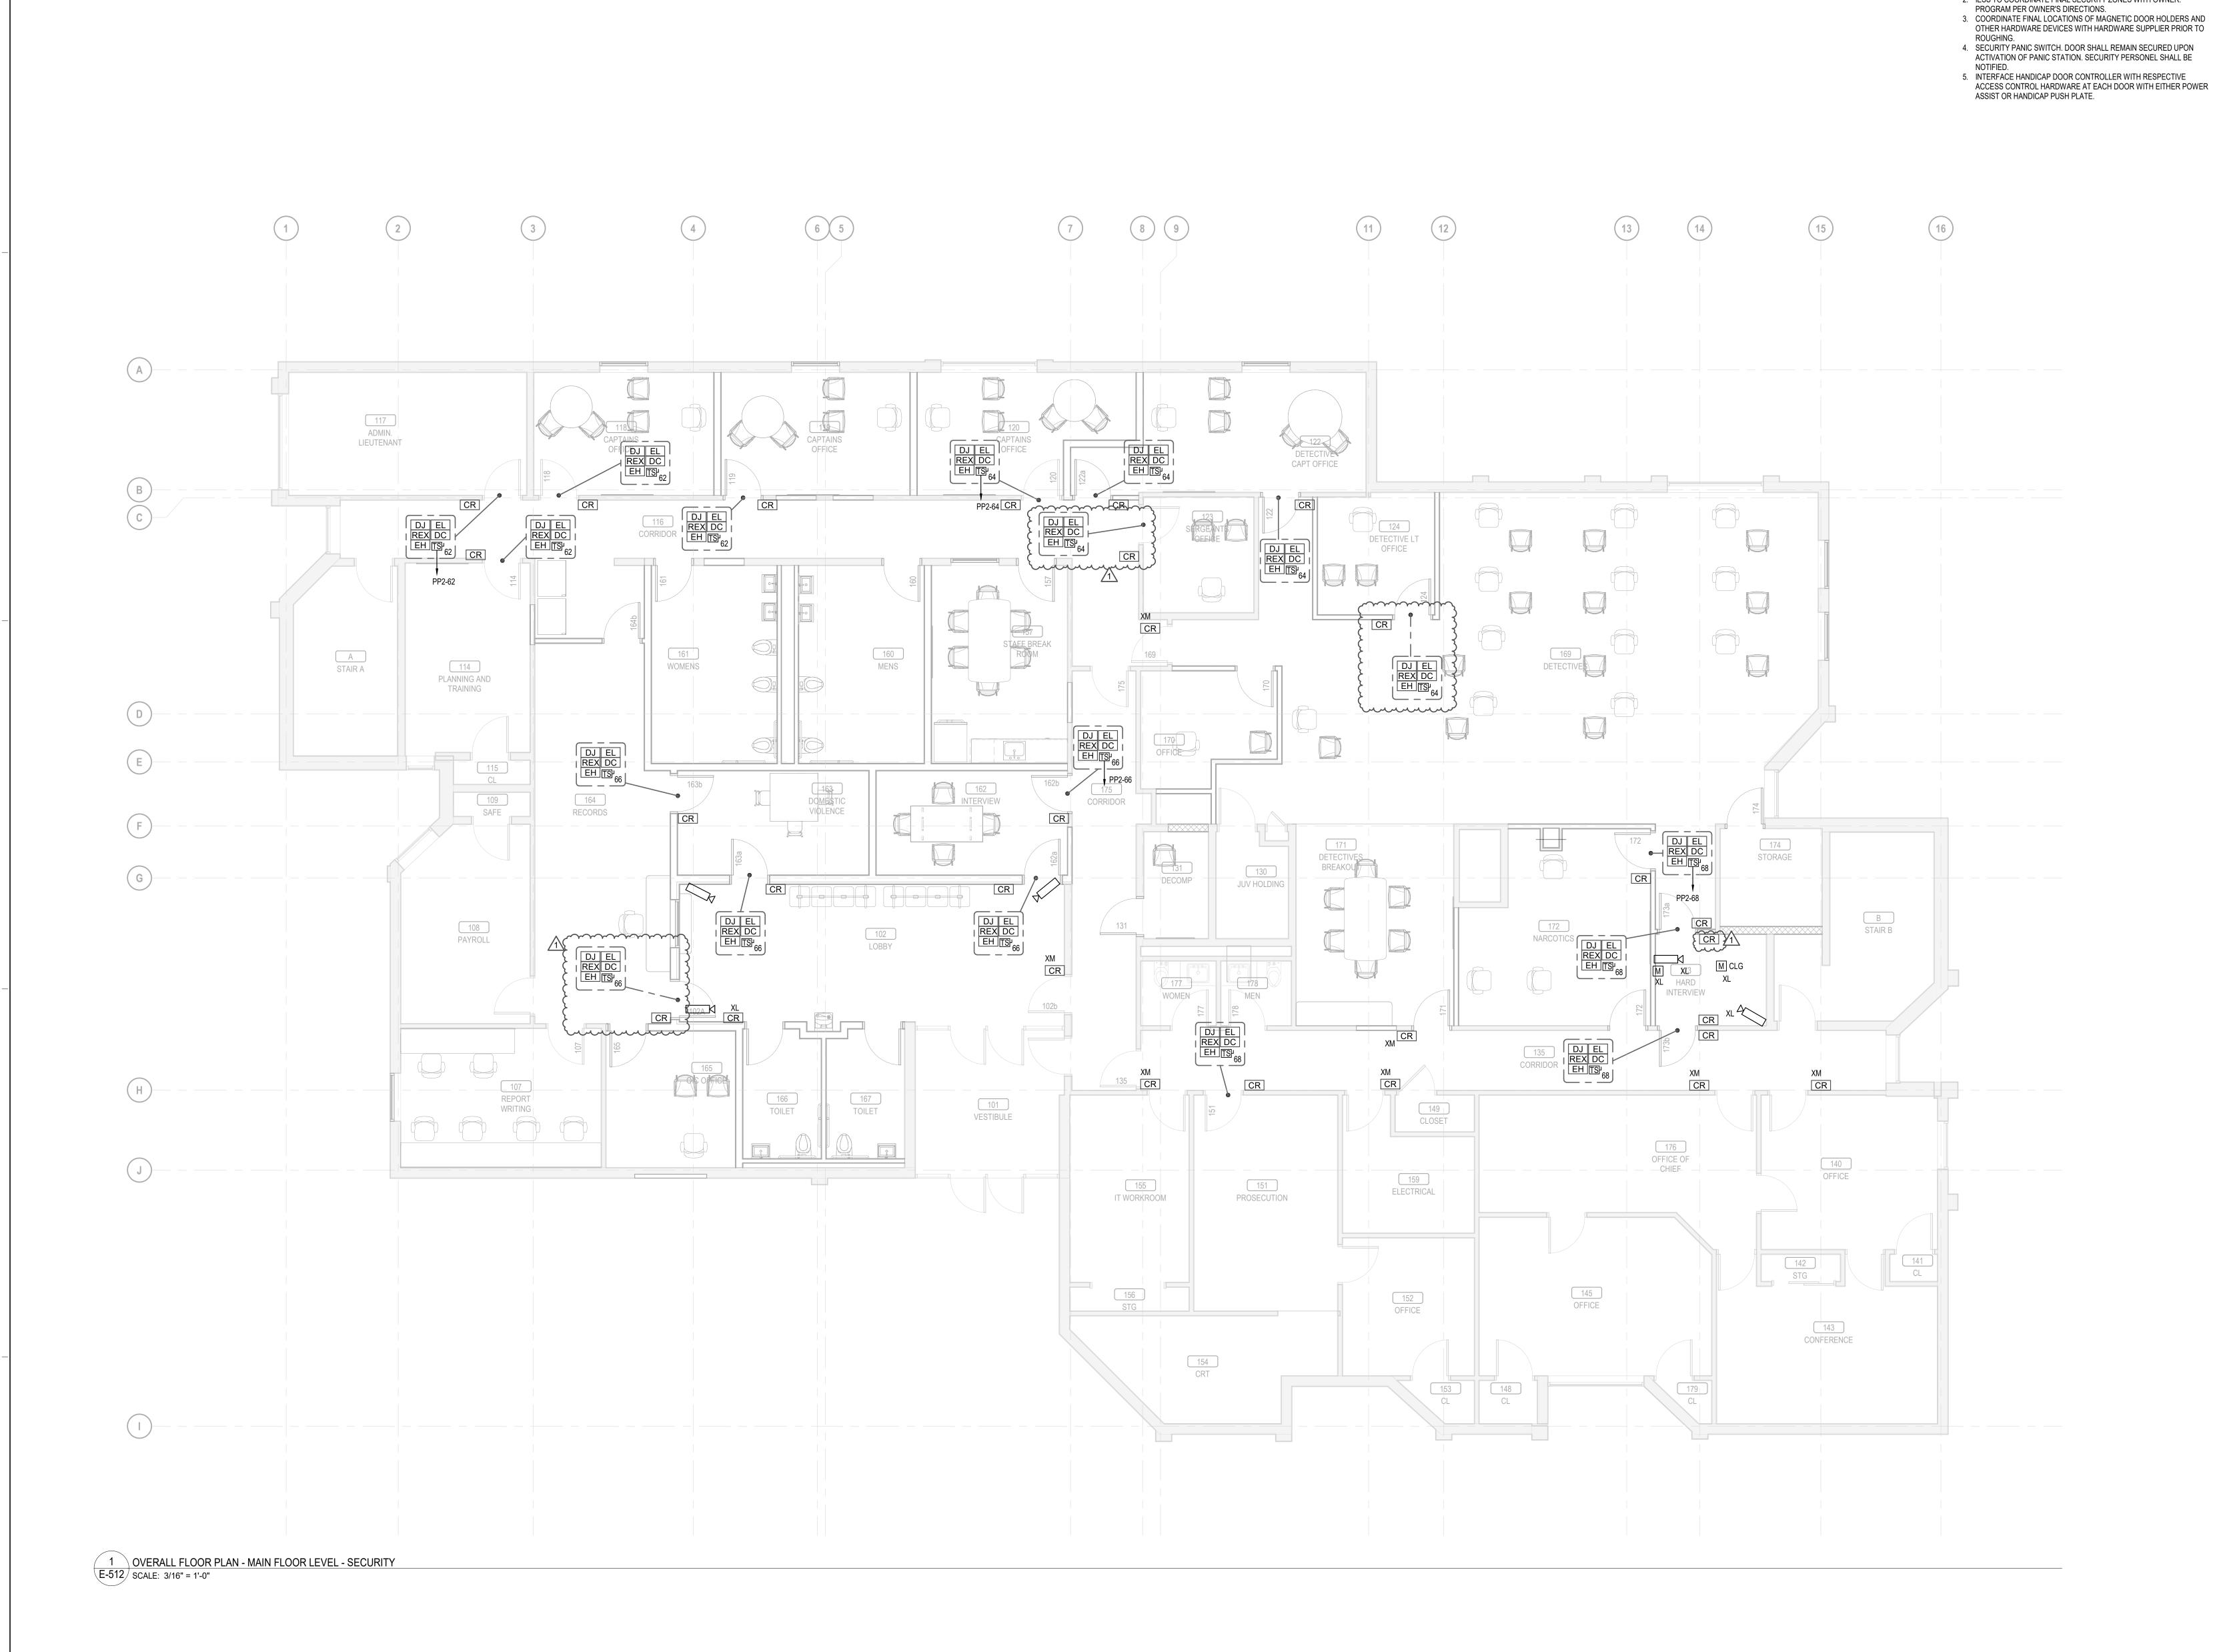

GENERAL SECURITY NOTES:

1. PROVIDE CORNER MOUNTED MOTION SENSOR WHENEVER

2. IESS TO COORDINATE FINAL SECURITY ZONES WITH OWNER.

750 WATERMAN AVE EAST PROVIDENCE, RI 02914

STATE PROJECT NUMBER < remove if not required>

JCJARCHITECTURE


120 HUYSHOPE AVENUE
SUITE 400
HARTFORD, CT 06106
860.247.9226

© 2023 JCJ Architecture



GGD CONSULTING ENGINEERS, INC. 375 Faunce Corner Road, Suite D, Dartmouth, MA 02747-1258 p: 508-998-5700 • f: 508-998-0883 • E-MAIL: info@g-g-d.com

CONSTRUCTION DOCUMENTS 06/03/2024

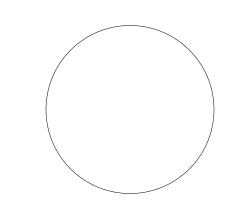

PIC [WHO] _____ DL [WHO] ___

ISSUE _ ISSUE DATE

JOB _ JCJ PROJECT NUMBER: B23036.00

DRAWN _ JR

SCALE As indicated

REVISIONS

07/08/2024 Addendum 1

MAIN LEVEL - SECURITY PLAN



750 WATERMAN AVE East Providence, RI 02914

STATE PROJECT NUMBER < remove if not required>

JCJARCHITECTURE


120 HUYSHOPE AVENUE
SUITE 400
HARTFORD, CT 06106
860.247.9226

© 2023 JCJ Architecture



GGD CONSULTING ENGINEERS, INC. 375 Faunce Corner Road, Suite D, Dartmouth, MA 02747-1258 p: 508-998-5700 • f: 508-998-0883 • E-MAIL: info@g-g-d.com

CONSTRUCTION DOCUMENTS 06/03/2024

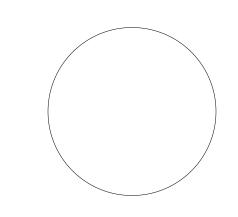

PIC [WHO] _____ DL [WHO] ____

PM [WHO] _____ DTL [WHO] ____

ISSUE _ISSUE DATE

JOB __JCJ PROJECT NUMBER: B23036.00_
DRAWN __JR

SCALE As indicated
REVISIONS

07/08/2024 Addendum 1

LOWER LEVEL -TECHNOLOGY PLAN

T-111

1 MAIN FLOOR LEVEL - TECHNOLOGY T-112 SCALE: 3/16" = 1'-0"

EAST PROVIDENCE POLICE DEPT RENOVATIONS

GENERAL TECHNOLOGY NOTES:

COMMUNICATIONS OUTLETS ARE SHOWN FOR REFERENCE PURPOSES. EXACT LOCATIONS WILL BE AS SHOWN ON

ELECTRICAL DRAWINGS. COORDINATE INSTALLATION OF ALL CABLING WITH ELECTRICAL SUBCONTRACTOR.

2. KEEP COMMUNICATIONS CABLING AT LEAST 12" AWAY FROM

750 WATERMAN AVE East Providence, RI 02914

STATE PROJECT NUMBER < remove if not required>

JCJARCHITECTURE

120 HUYSHOPE AVENUE
SUITE 400
HARTFORD, CT 06106
860.247.9226


© 2023 JCJ Architecture



375 Faunce Corner Road, Suite D, Dartmouth, MA 02747-1258

p: 508-998-5700 • f: 508-998-0883 • E-MAIL: info@g-g-d.com

CONSTRUCTION DOCUMENTS 06/03/2024

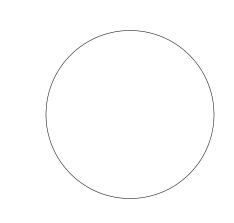

PIC [WHO] _____ DL [WHO] _____ PM [WHO] ____ DTL [WHO] ____

JOB JCJ PROJECT NUMBER: B23036.00

DRAWN JR

SCALE As indicated


SCALE As indicated

REVISIONS

07/08/2024 Addendum 1

MAIN LEVEL - TECHNOLOGY PLAN

T-112

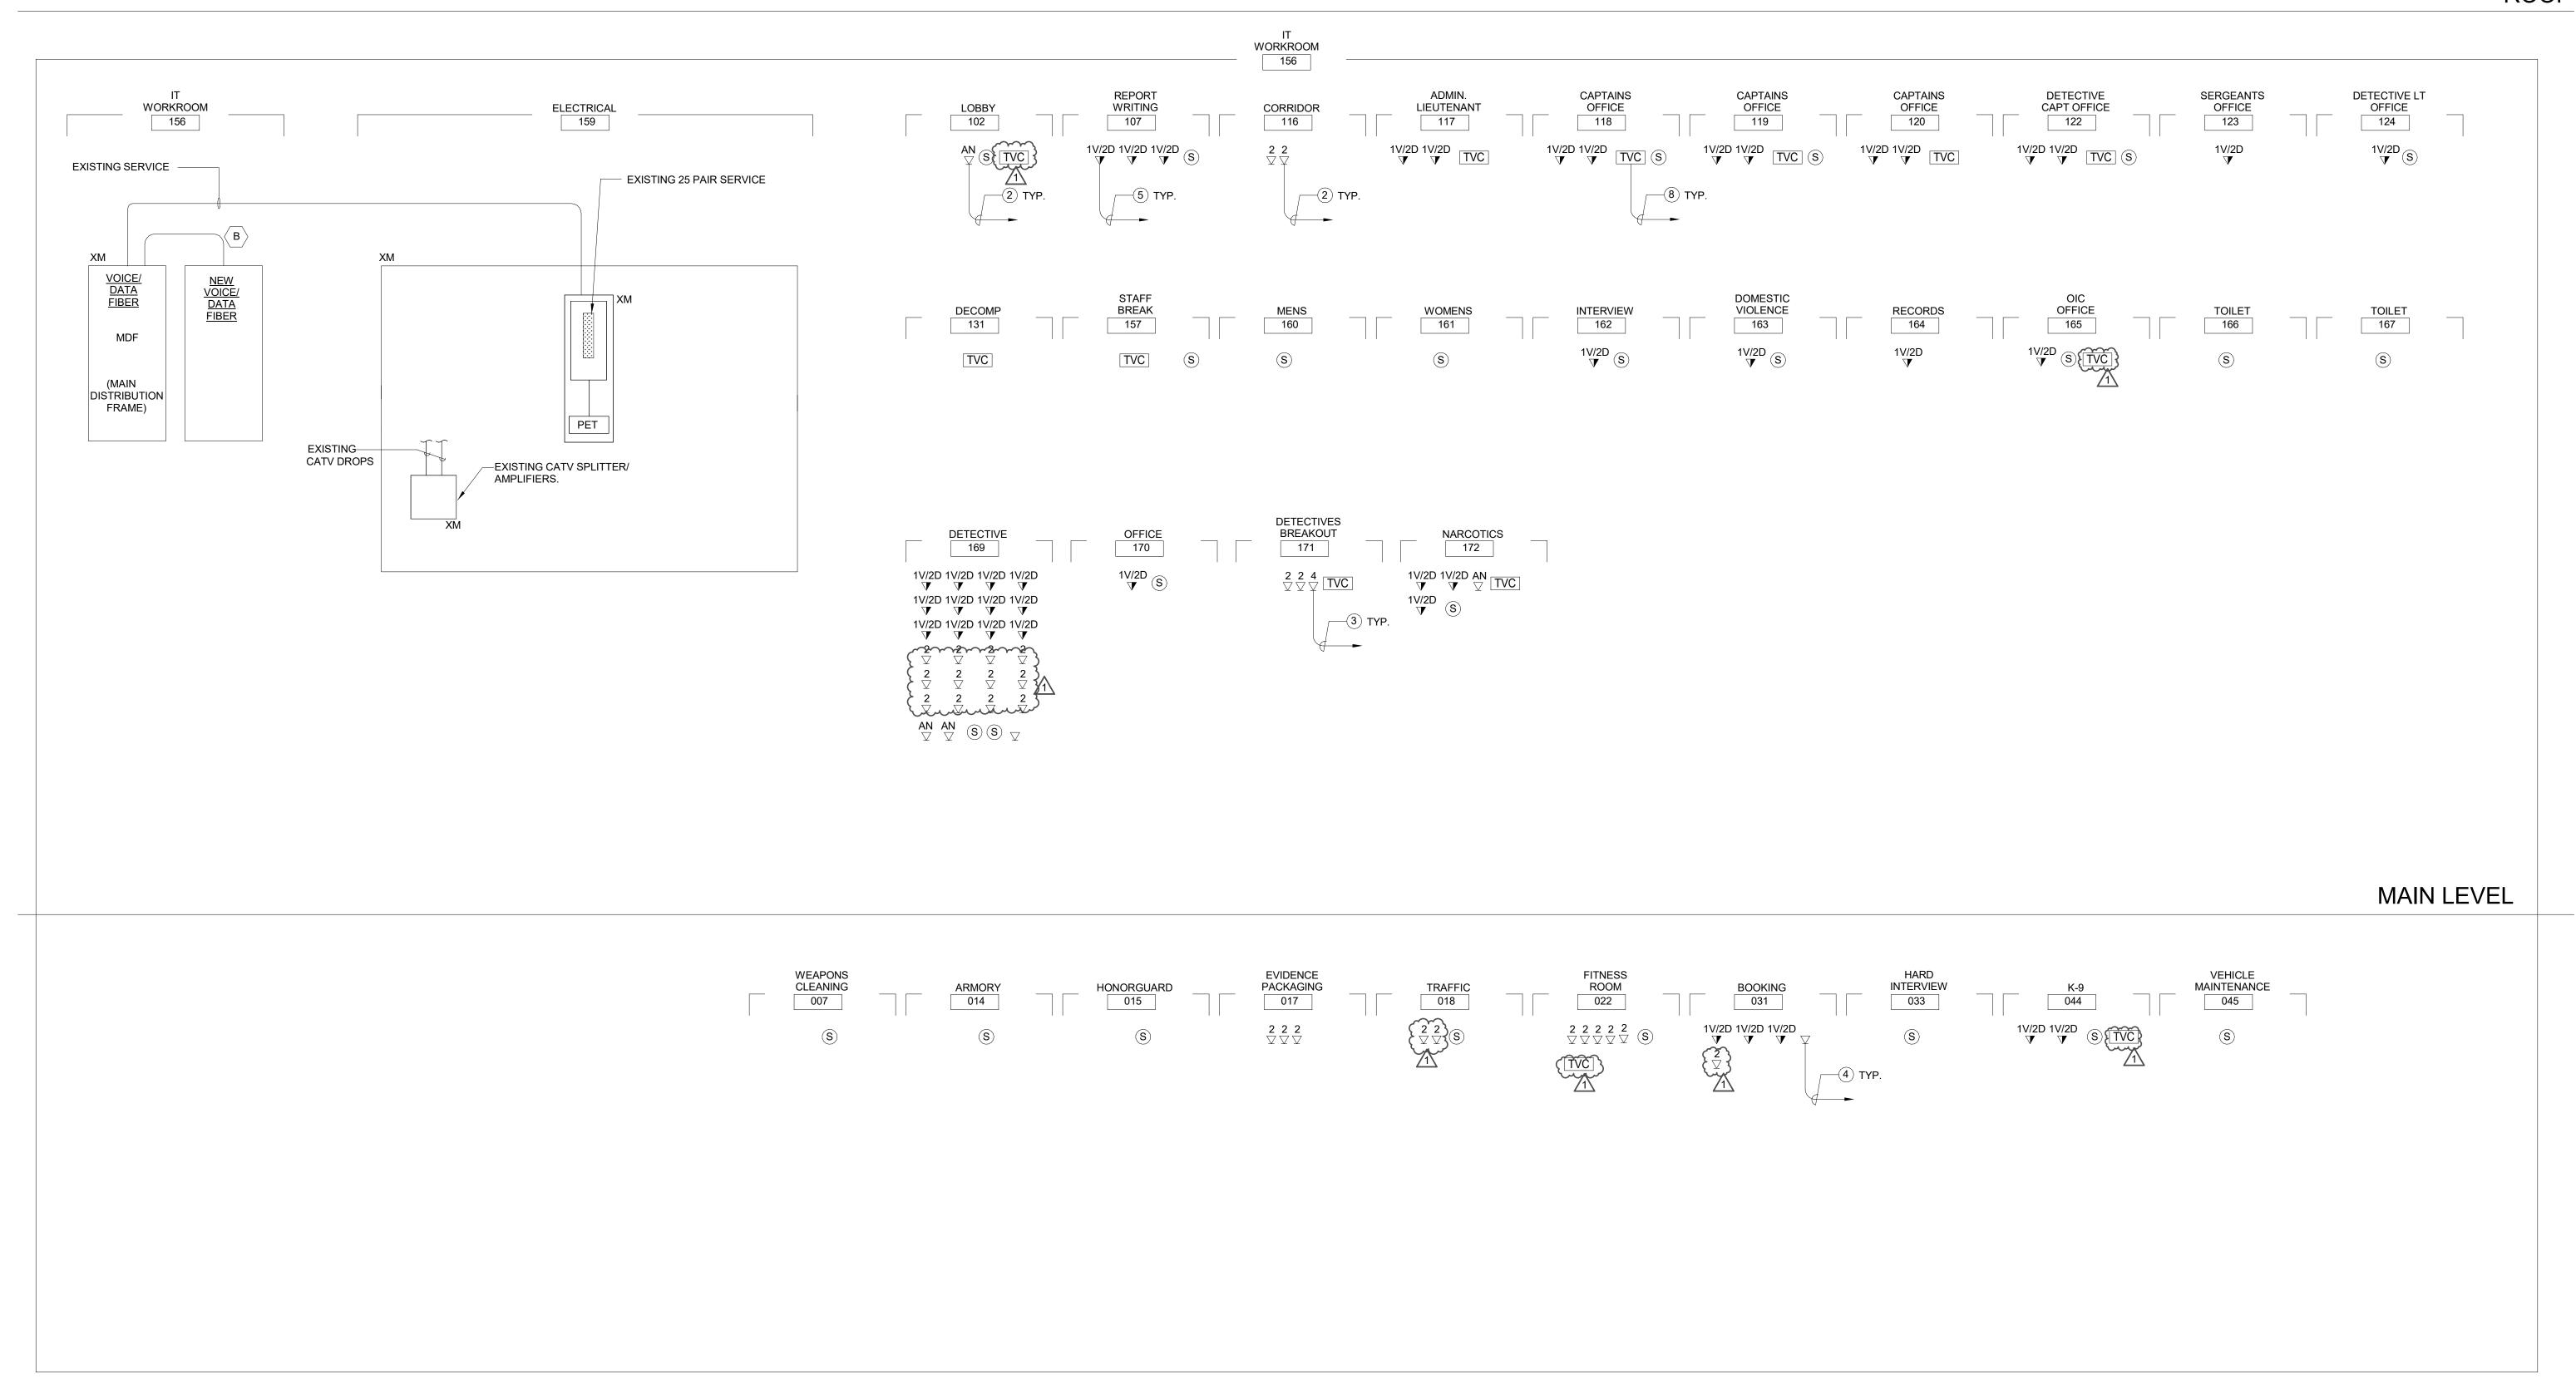

LOWER LEVEL

(1) - (1) CAT 6A UTP CABLE PLÉNUM RATED TO IDF/MDF DATA RACK IN BLOCKED AREA (TYPICAL)

(2) - (2) CAT 6A UTP CABLES PLÉNUM RATED TO IDF/MDF DATA RACK IN BLOCKED AREA (TYPICAL)

(3) - (4) CAT 6A UTP CABLES PLENUM RATED TO IDF/MDF DATA RACK IN BLOCKED AREA (TYPICAL)

(4) - (1) CAT 6A UTP CABLE PLENUM RATED TO IDF/MDF DATA RACK IN BLOCKED AREA & (1) CAT 6A UTP CABLE PLENUM RATED TO IDF/MDF VOICE RACK

IN BLOCKED AREA (TYPICAL)

(5) - (2) CAT 6A UTP CABLES PLÉNUM RATED TO IDF/MDF DATA RACK IN BLOCKED AREA & (1) CAT 6A UTP CABLES PLENUM RATED TO IDF/MDF VOICE RACK IN **BLOCKED AREA**

- (2) CAT 6A UTP CABLES PLENUM RATED TO IDF/MDF IN BLOCKED AREA. 2 STRAND MULTI-MODE LASER OPTIMIZED ARMORED FIBER CABLE TO IDF/MDF IN BLOCKED AREA (TYPICAL)

- (1) CAT 6A UTP CABLE

IDF/MDF VOICE RACK IN

PLENUM RATED TO

BLOCKED AREA

(TYPICAL)

(9) - (4) CAT 6A UTP CABLES PLÉNUM RATED TO IDF/MDF DATA RACK IN BLOCKED AREA (TYPICAL)

12 STRAND MULTI-MODE (8) - (2) CAT 6A UTP CABLES FIBER CABLE TO PLÉNUM RATED TO IDF/MDF DATA MDF. INSTALL PLENUM RACK IN BLOCKED AREA - (1) RATED INNER-DUCT. RG-6 QUAD SHIELD TO CATV

B 6 STRAND SINGLE MODE

RATED INNER-DUCT.

SPLITTER IN CORRIDOR

C 2 STRAND OUTSIDE PLANT SINGLE MODE 8/9 MICRON FIBER CABLE TO MDF. INSTALL PLENUM RATED

INNER-DUCT. D 4 STRAND OUTSIDE PLANT 8/9 MICRON FIBER CABLE SINGLE MODE 8/9 MICRON TO MDF. INSTALL PLENUM FIBER CABLE TO MDF. INSTALL PLENUM RATED INNER-DUCT.

1. THIS CONTRACTOR SHALL PROVIDE FOR A COMPLETE INSTALLATION. FURNISH ALL EQUIP. LABOR, WIRING AND OUTLETS REQUIRED FOR A COMPLETELY OPERATIONAL SYSTEM.

PRIOR TO ROUGHING-IN.

OF DATA PATCH PANELS TO ACCOMODATE ALL RESPECTIVE DATA CIRCUITS. 4. PROVIDE CAT 6A PATCH CORDS TO MATCH TOTAL QUANTITY OF 2. ALL WIRING SHALL BE IN ACCORDANCE PATCH PANEL PORTS. AT BOTH MDF/IDF WITH EQUIPMENT SUPPLIER. AND WORK STATION. COORDINATE ALL WIRING REQUIREMENTS

3. PROVIDE APPROPRIATE QUANTITIES


TECHNOLOGY RISER DIAGRAM $\overline{\mathsf{T}}\text{-200}$ scale: NOT TO SCALE

EAST PROVIDENCE **POLICE DEPT RENOVATIONS**

750 WATERMAN AVE EAST PROVIDENCE, RI 02914


JCJARCHITECTURE 120 HUYSHOPE AVENUE SUITE 400 HARTFORD, CT 06106 860.247.9226

© 2023 JCJ Architecture

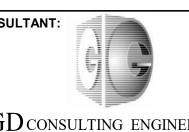

p: 508-998-5700 • f: 508-998-0883 • E-MAIL: info@g-g-d.con

CONSTRUCTION DOCUMENTS 06/03/2024

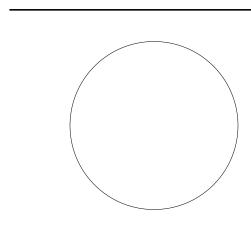

PIC [WHO] _____ DL [WHO] _____ PM [WHO] _____ DTL [WHO]

ISSUE _ISSUE DATE JOB __JCJ PROJECT NUMBER: B23036.00_

DRAWN JR

REVISIONS 07/08/2024 Addendum 1

TECHNOLOGY RISER